


T.40S.R.14 W., W.M.

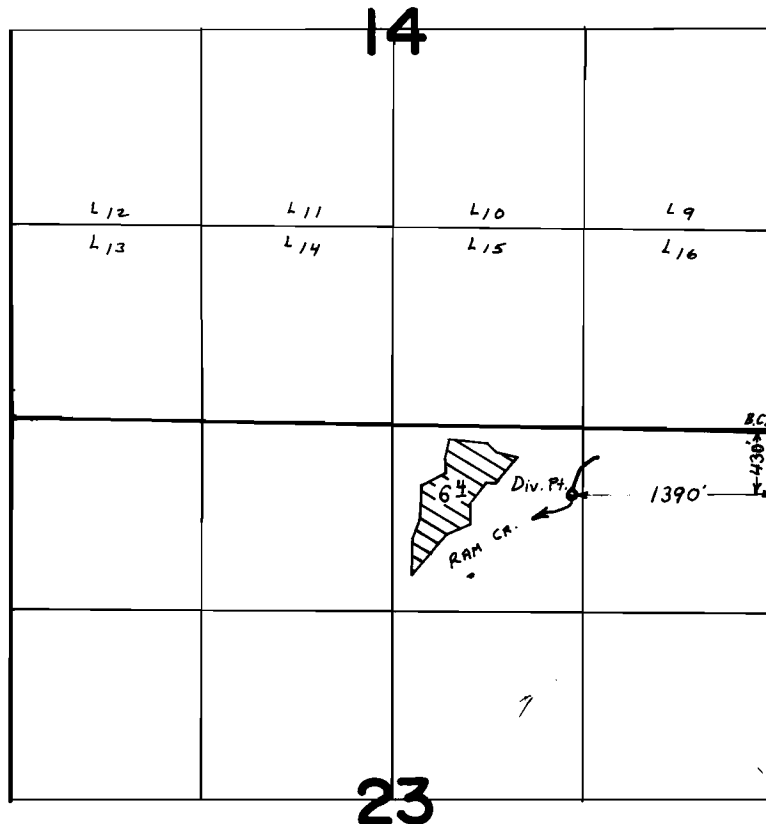

FINAL PROOF SURVEY
UNDER

Application No. 39291..... Permit No. 29260....
IN NAME OF

.....FRED A. & MAY R. BLUNT.....

Surveyed AUG. 28. 1976., by L. H. NUNN.....
NOV 30 1977 D. W. SPARKS