


# T. 26 S., R. 3 W., W.M.

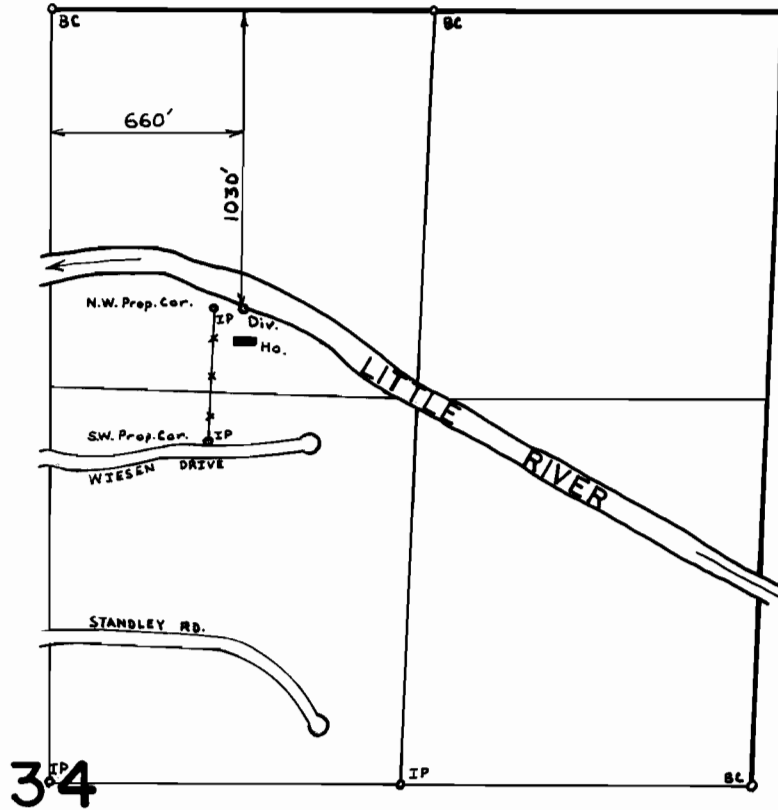

SCALE: 1" = 660'

## FINAL PROOF SURVEY UNDER

Application No. 55038 Permit No. 41222  
IN NAME OF

WILLIAM E. SPIELMAN

Surveyed MAR. 30, 1978, by D.W. SPARKS