


T.28S., R.8W.,W.M.

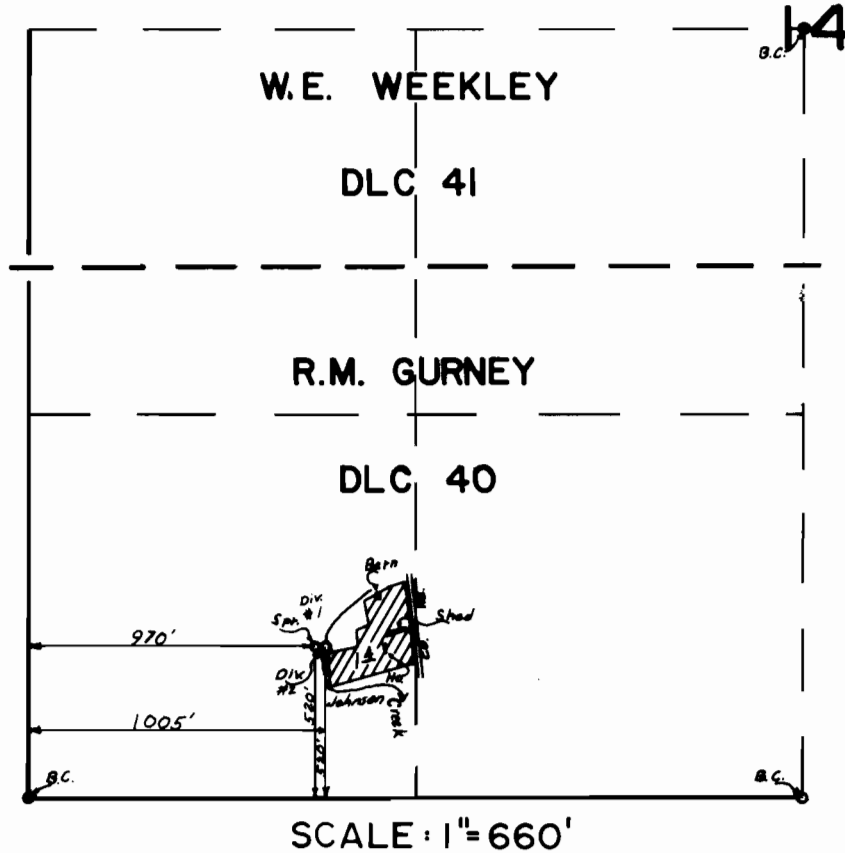

FINAL PROOF SURVEY
UNDER

Application No. 54663 Permit No. 41012
IN NAME OF

JOHN N. BRINT

Surveyed NOV. 10 1977, by D.W. SPARKS