


T. 27 & 28S., R. 6 W., W.M.

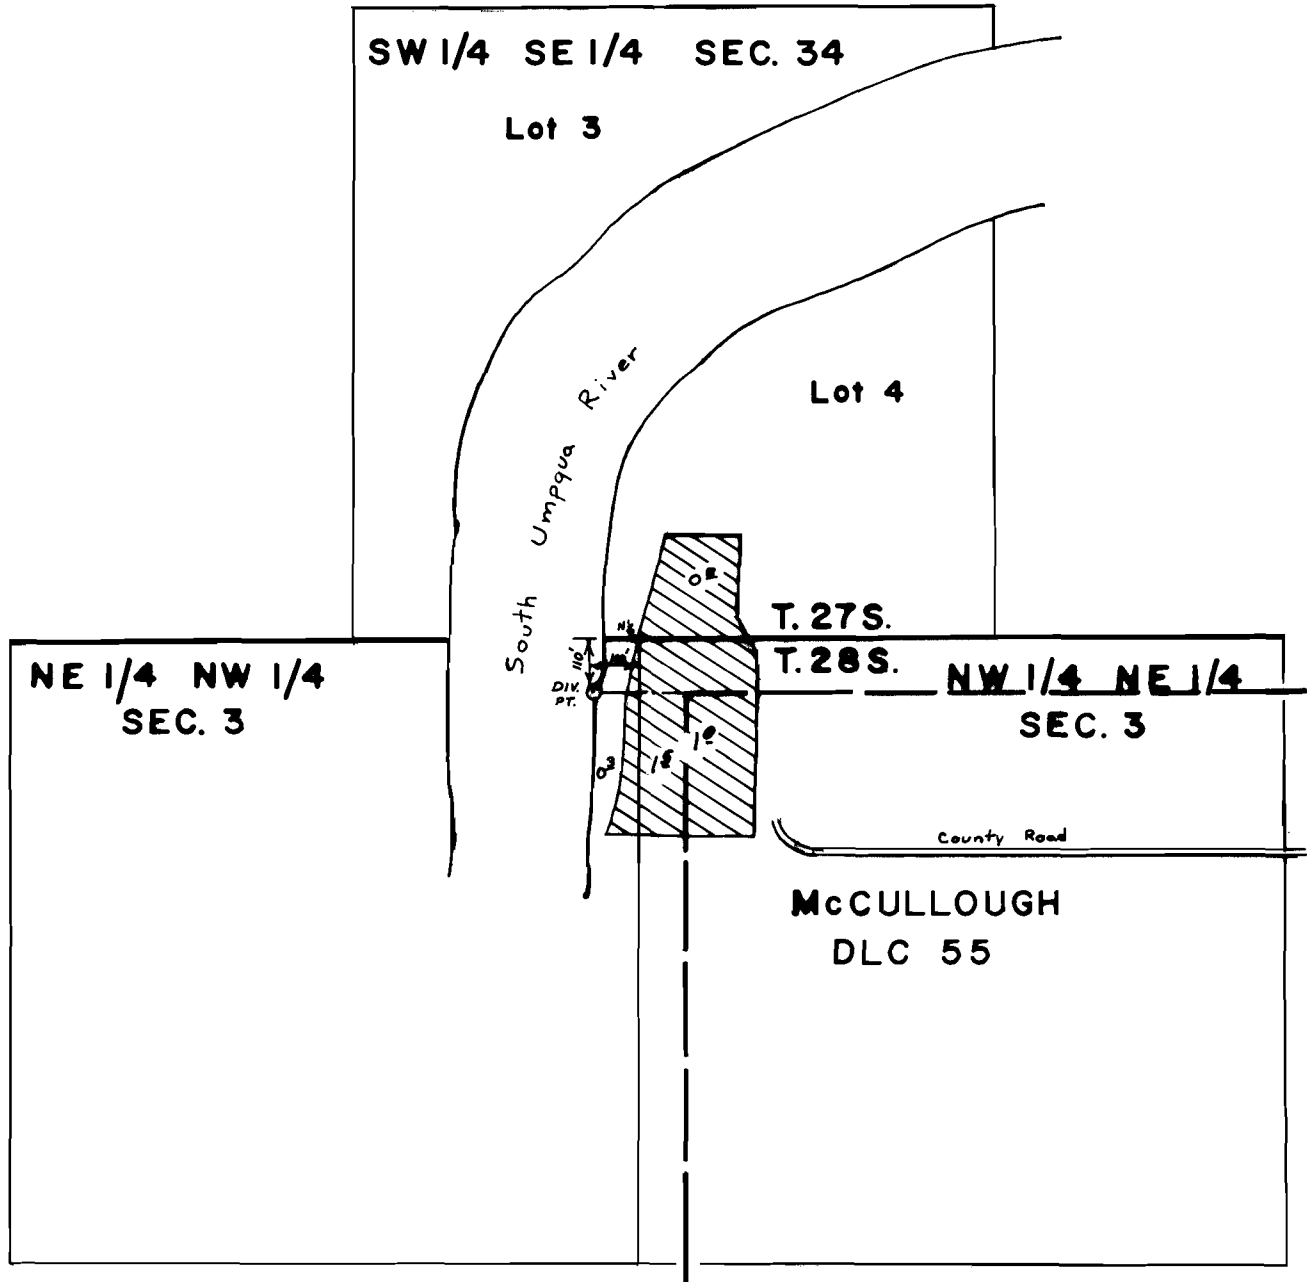

FINAL PROOF SURVEY
UNDER

SCALE 1" = 400'

Application No. 54340. Permit No. 40736.
IN NAME OF

..... Ray and Sandra Wimberly

Surveyed Sept. 7, 1979, by S. Donaldson.