


T.26 S. R.3 W. W.M.

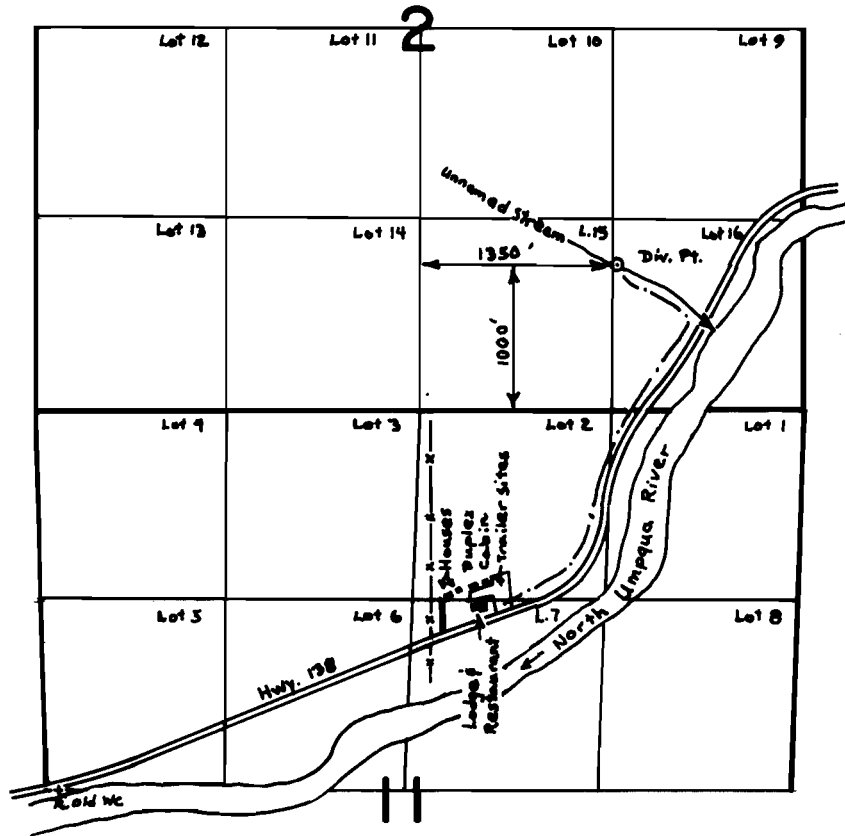

SCALE: 4" = 1 mile

**FINAL PROOF SURVEY**  
UNDER

Application No. 49096 Permit No. 36829.  
IN NAME OF

DAVID L. & MAYME M. COTA

Surveyed June 29, 1978, by D. Sparks.....