


T.25S. R.7W. W.M. .

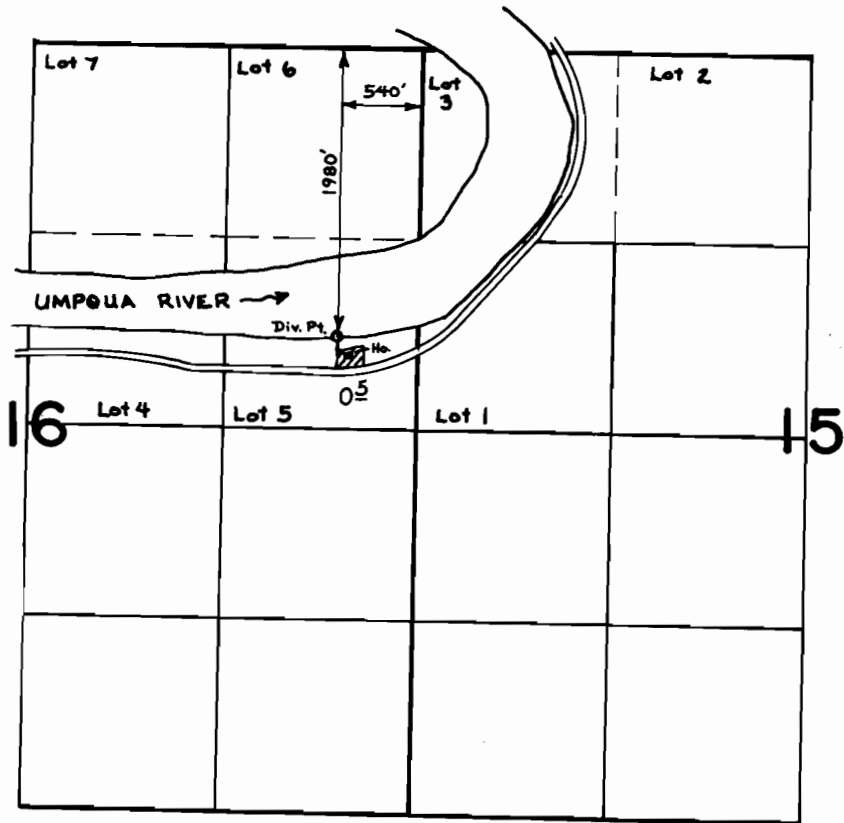

SCALE: 4" = 1 mile

FINAL PROOF SURVEY
UNDER

Application No. 52886 Permit No. 39913

IN NAME OF

ROBERT JAMES MEIER

Surveyed Nov. 2, 1977, by D. Sparks