


T. 27 & 28 S., R. 5 W., W.M.

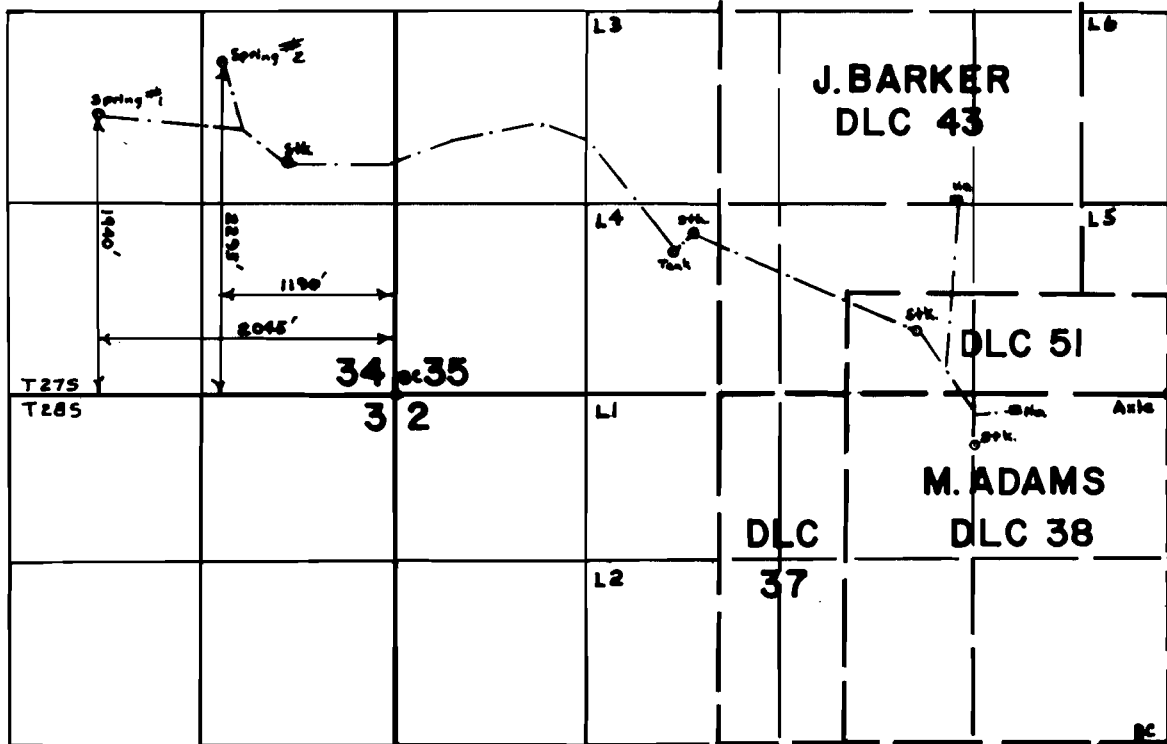

FINAL PROOF SURVEY UNDER

Application No. 54490 Permit No. 40866
IN NAME OF

HOWARD HATFIELD

Surveyed OCT. 21 1977, by D.W. SPARKS