


T.2IS. R.4W. W.M.

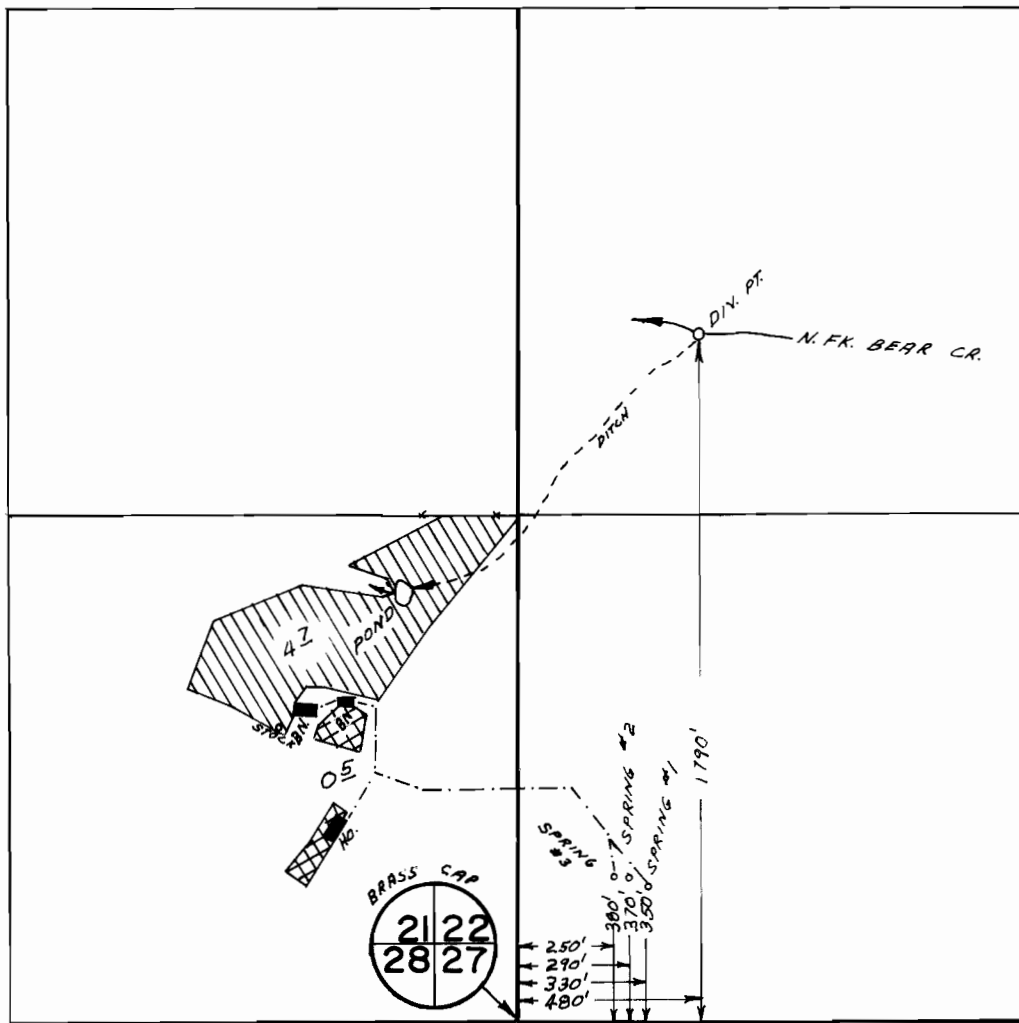

SCALE 1"= 500'

FINAL PROOF SURVEY

UNDER



N. Fk. BEAR CR.



SPRINGS

Application No. 50454 Permit No. 38107
IN NAME OF

MICHAEL J. & NORMA R. MRVICH

Surveyed APR. 22 1977, by L.H. NUNN.....