


T. 29 S., R. 7 W., W.M.

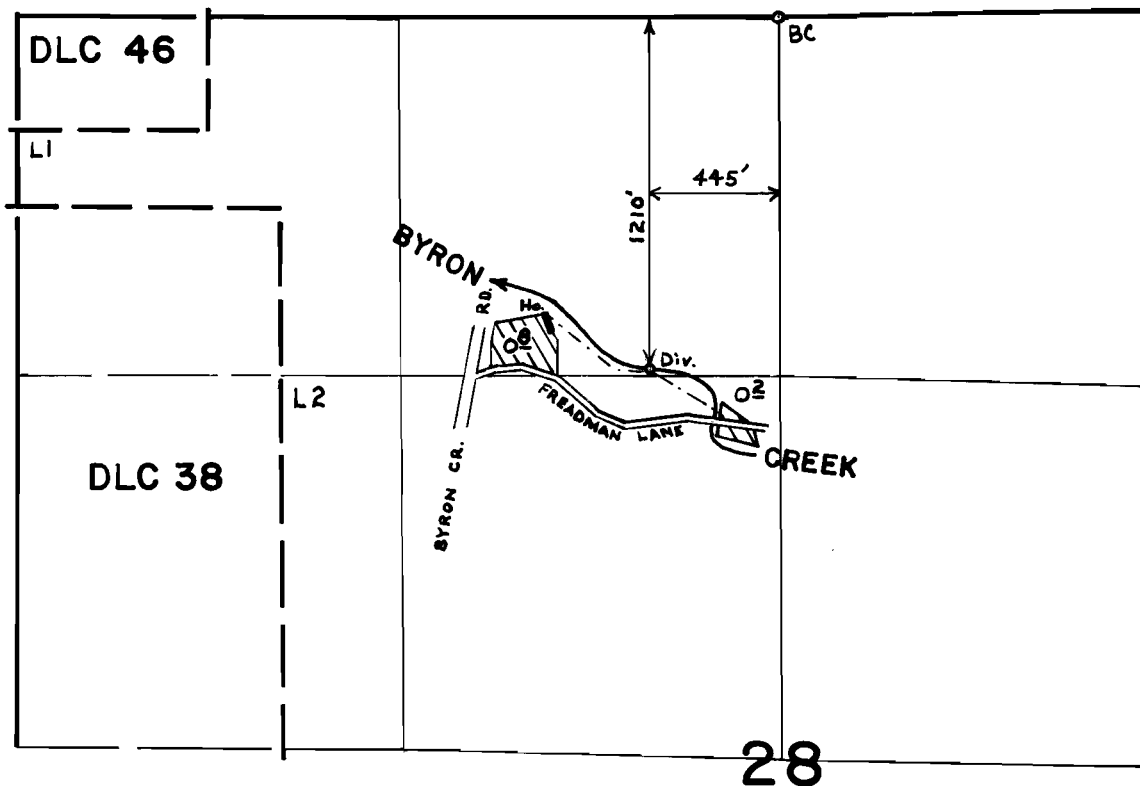

SCALE: 1" = 660'

**FINAL PROOF SURVEY**  
UNDER

Application No. 49894 Permit No. 37515  
IN NAME OF

PAUL DON MONTAGUE

Surveyed JUNE 20 1978, by D.W. SPARKS