


T. 29 S., R. 8 W., W.M.

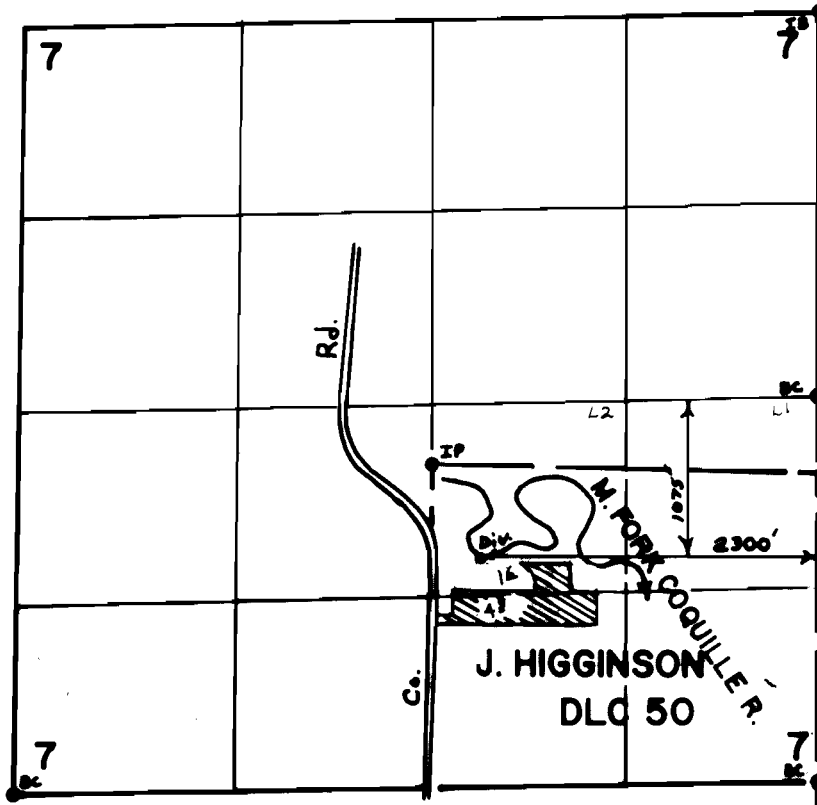

FINAL PROOF SURVEY
UNDER

Application No. 49302. Permit No. 36967.
IN NAME OF

.....
KEITH DAHL
.....

Surveyed NOV. 15. 1977, by D.W. SPARKS.....