


T. 29S. R. 6W. W.M.

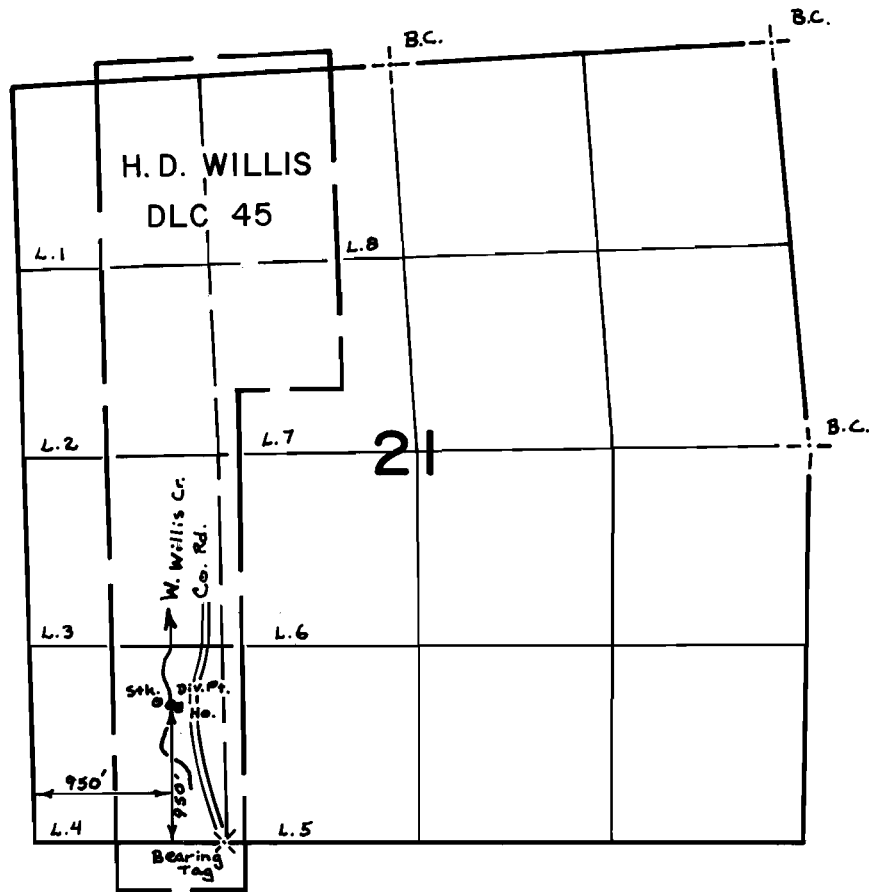

FINAL PROOF SURVEY
UNDER

Application No. 49189 Permit No. 36875
IN NAME OF

PETER J. RASMUSSEN

Surveyed Sept. 13, 1978, by D. Henry