


T.22S., R.7W., W.M

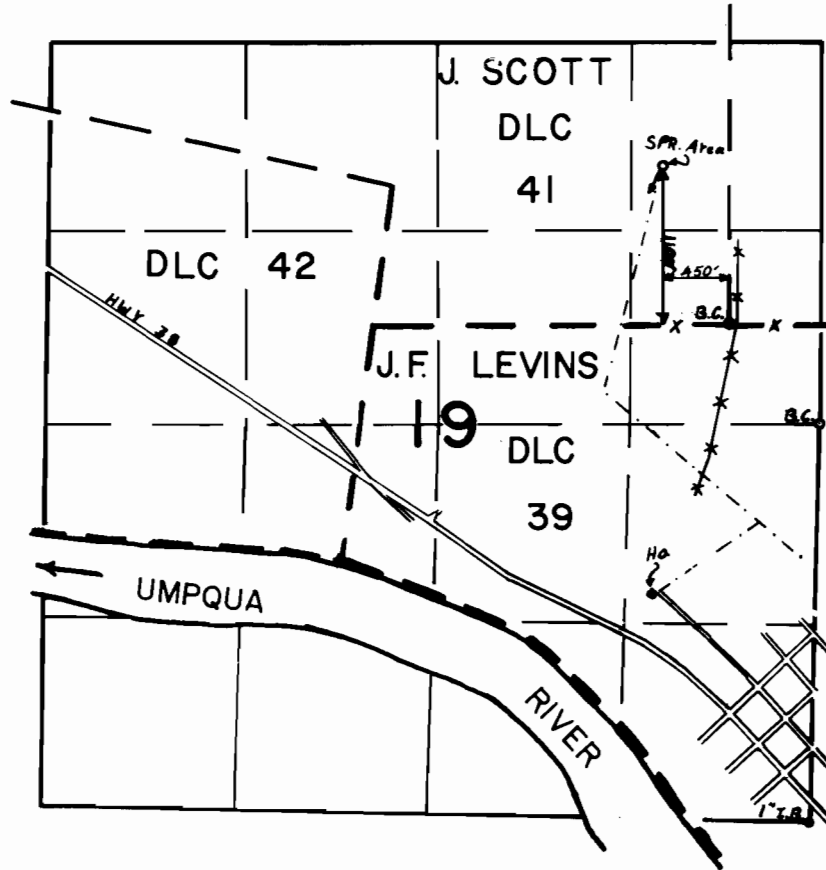

FINAL PROOF SURVEY UNDER

Application No. 50741 Permit No. 38323
IN NAME OF

HENRY AND/OR LOIS BECKLY

Surveyed JAN. 18. 1978., by D. W. SPARKS.