


T. 28 <sup>1</sup>/<sub>E</sub> 29 S. R. 4 W. W.M.

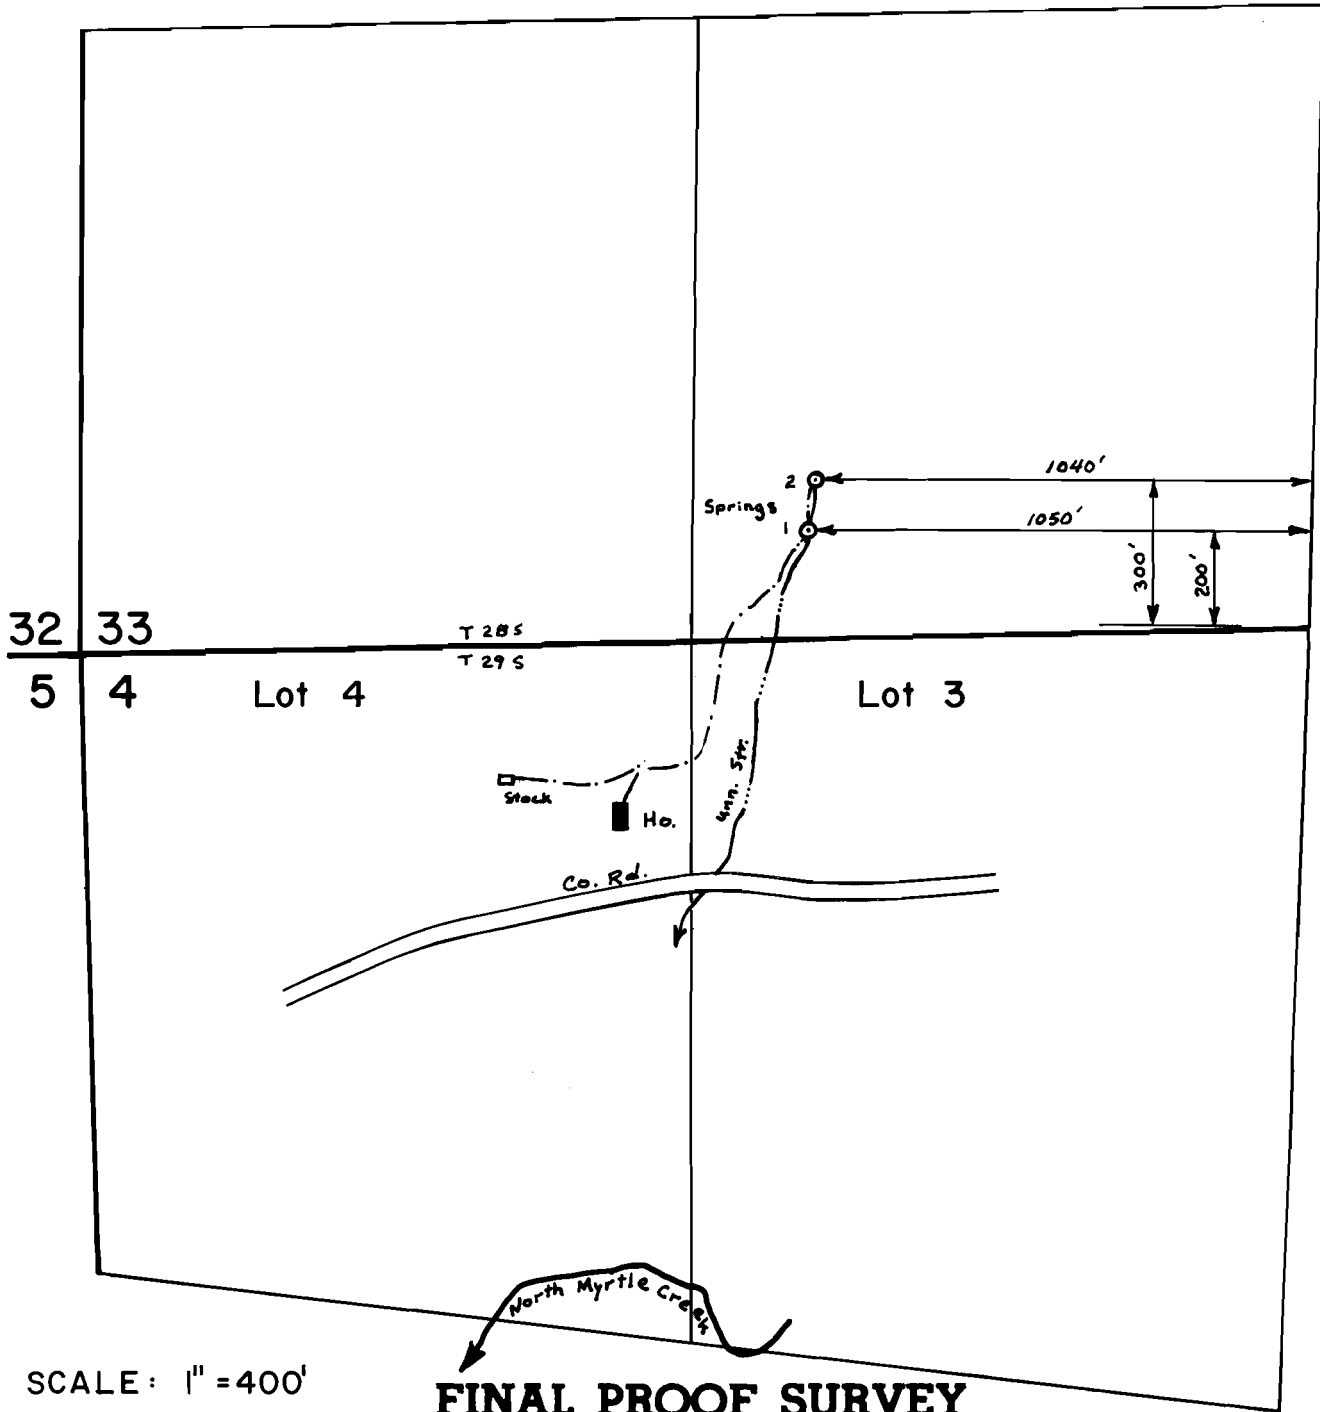

**FINAL PROOF SURVEY**  
UNDER

Application No. 54436 Permit No. 40823  
IN NAME OF

.....THOMAS A. AND PEARLEEN K. BENNET.....

Surveyed Oct. 26 1978, by D. Henry.....