


T.29S.,R.8 W.,W.M.

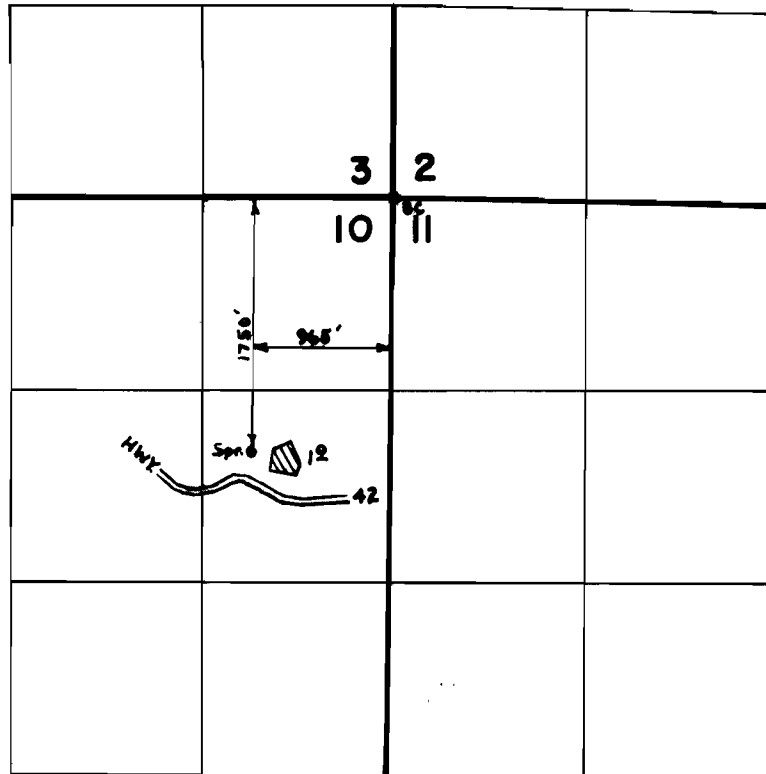

FINAL PROOF SURVEY
UNDER

Application No. 56654 Permit No. 42075
IN NAME OF

PAUL ALVY WARREN

Surveyed JUNE 22 1978, by D.W. SPARKS