


T. 26 S., R. 5 W., W.M.

SEC. 23

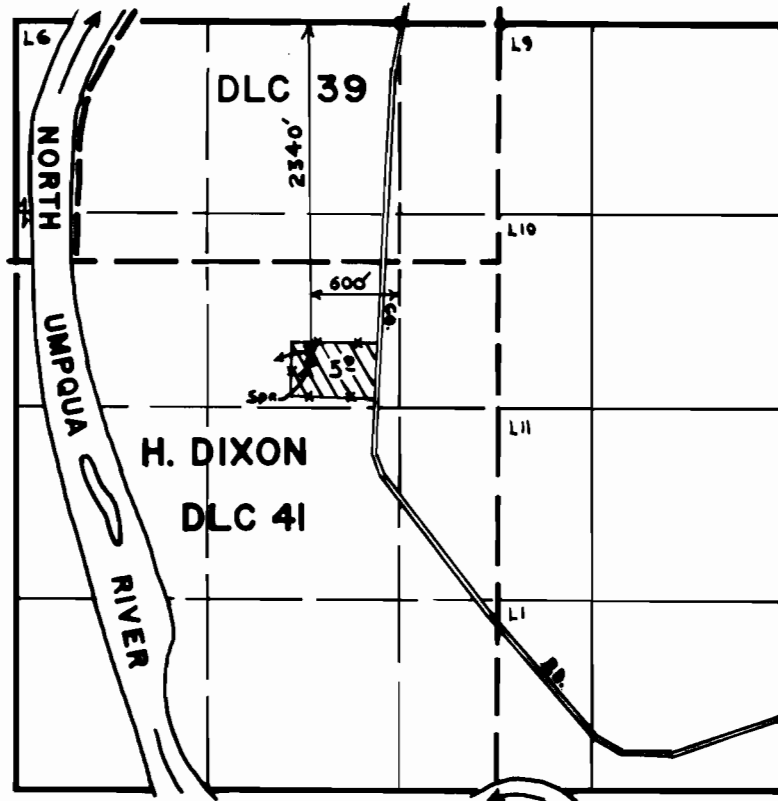

FINAL PROOF SURVEY
UNDER

Application No. 53679.. Permit No. 40136...
IN NAME OF

...ARLEY R. & OPAL M. FRICKE.

Surveyed MAR. 27. 1978, by D.W. SPARKS.....