


T.30S. R.5W. W.M.

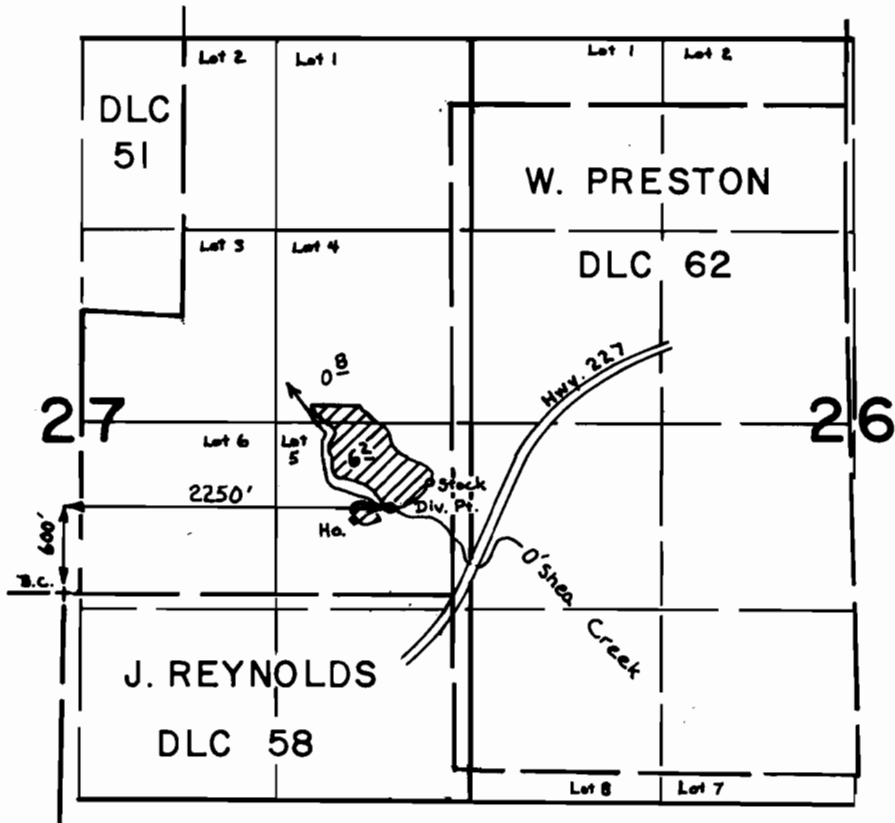

SCALE: 4" = 1 mile

FINAL PROOF SURVEY
UNDER

Application No. 53928 Permit No. 40180
IN NAME OF

GARY J. & MARTHA HEISLER

Surveyed Sept. 27, 1977, by D. Sparks