


T.2N.,R.10E.,W.M.

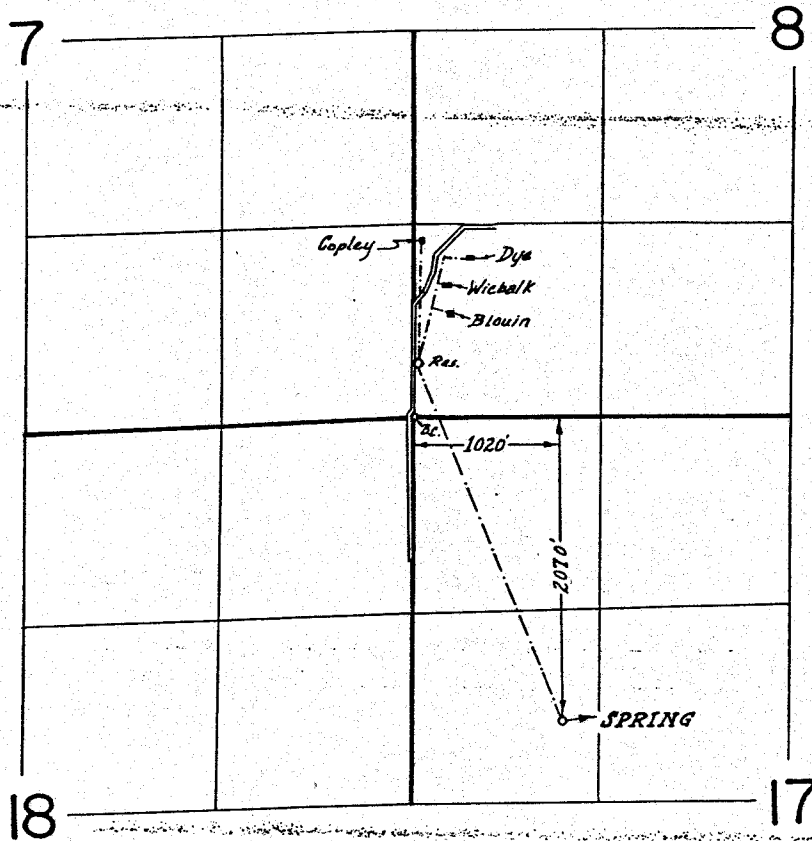

**FINAL PROOF SURVEY**  
UNDER

Application No. 55752 Permit No. 41749

IN NAME OF

LARRY F. COPLEY, et al.

Surveyed *May 9* 1978, by *A. Applegate*