


T.32S.R.32E.W.M.

SECTION 33

1" = 200'

SOLOMON CANYON RESERVOIR

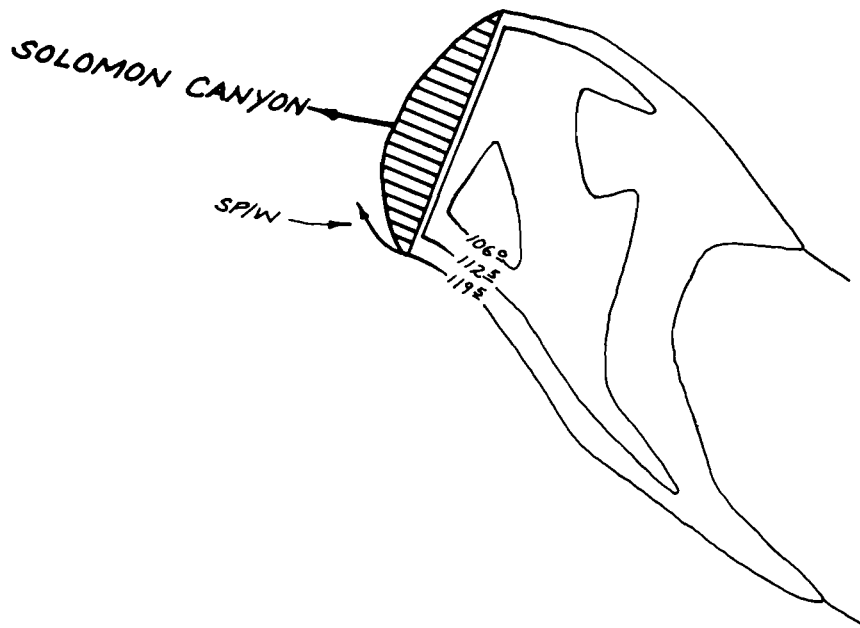

FINAL PROOF SURVEY
UNDER

Application No. R-41832 Permit No. R-4750
IN NAME OF

.....MR. ROBERTO FLORIANI.....

Surveyed JUNE 22, 1976, by R. MUCKEN...