


T. 36 S., R. 4 W., W.M.

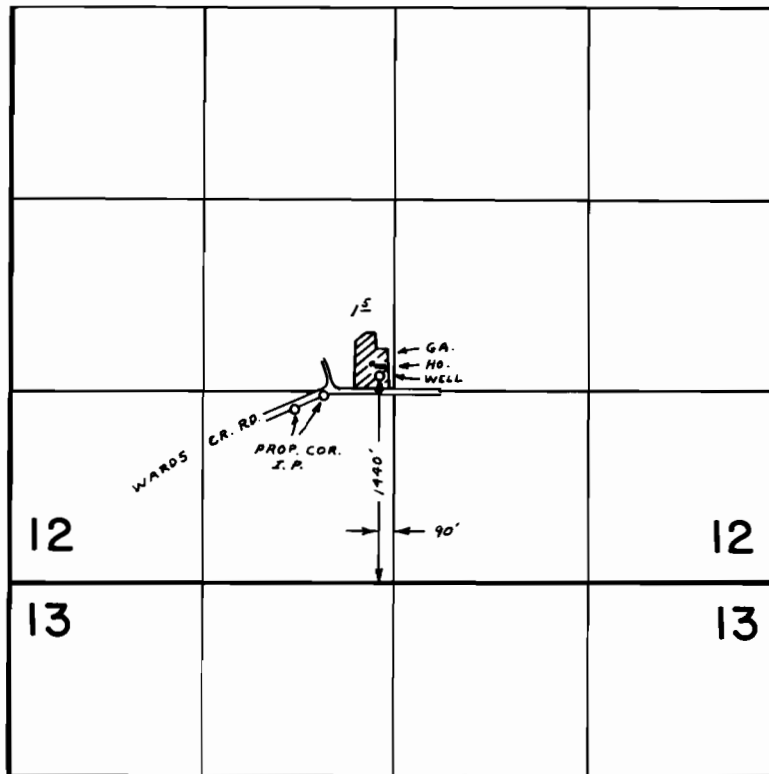

FINAL PROOF SURVEY
UNDER

Application No. G-7308 Permit No. G-6756
IN NAME OF

ALLISON MC ARTHUR & ROBERT D. WILSON

Surveyed MAY 17 1978, by B. SUND