


T. 38 & 39 S., R. 1 W., W.M.

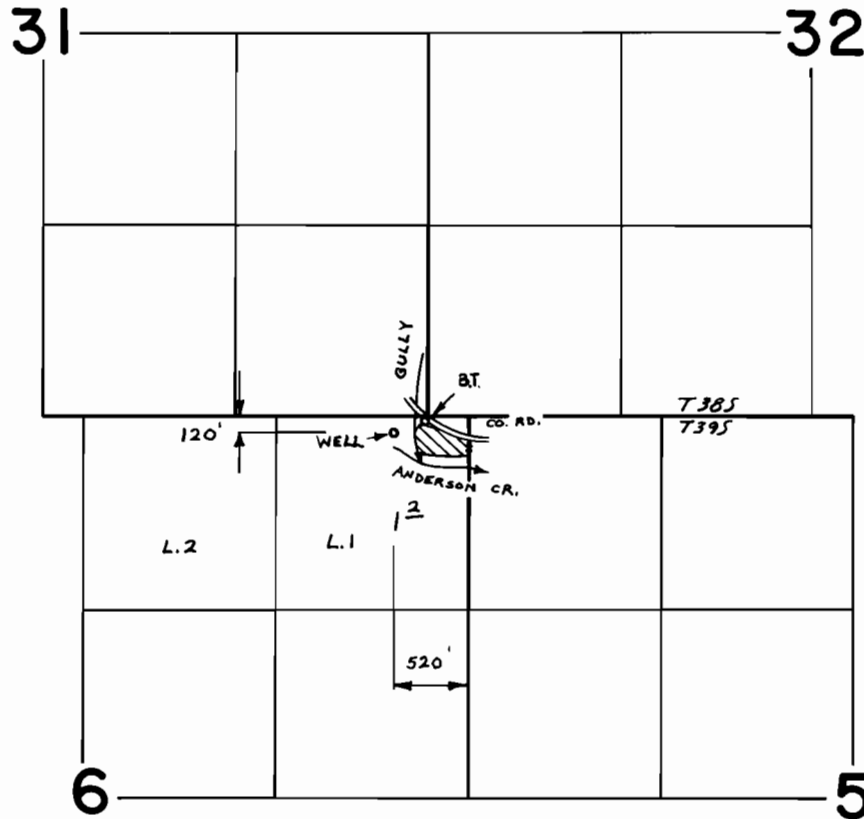

FINAL PROOF SURVEY
UNDER

Application No. G-7444 Permit No. G-6939
IN NAME OF

FREDERICK H. GERLOCK

Surveyed SEPT. 11 1978, by B. SUND

D.H.M.

P.T.S. - 1978 - 14 - C