


T.36 S., R.3 W., W.M.

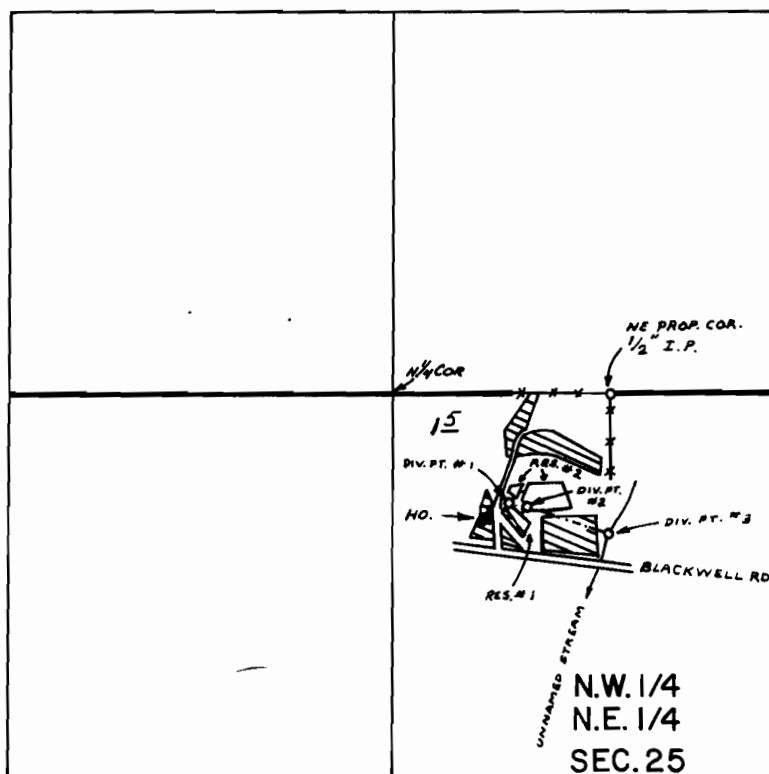

RES. #1 DIV. PT. LOC.: 370'S. & 400'E. FROM N 1/4 COR. SEC. 25
RES. #2 DIV. PT. LOC.: 380'S. & 460'E. FROM N 1/4 COR. SEC. 25
DIV. PT. #3: 480'S. & 740'E. FROM N 1/4 COR. SEC. 25

SCALE: 1" = 660 FT.

FINAL PROOF SURVEY

UNDER

R-48872 R-5931
48873 36619
Application No. Permit No.
IN NAME OF
HAROLD OR FAE ELDER
Surveyed NOV. 7 1978 by B. SUND