


T.36 S., R.3 W., W.M.

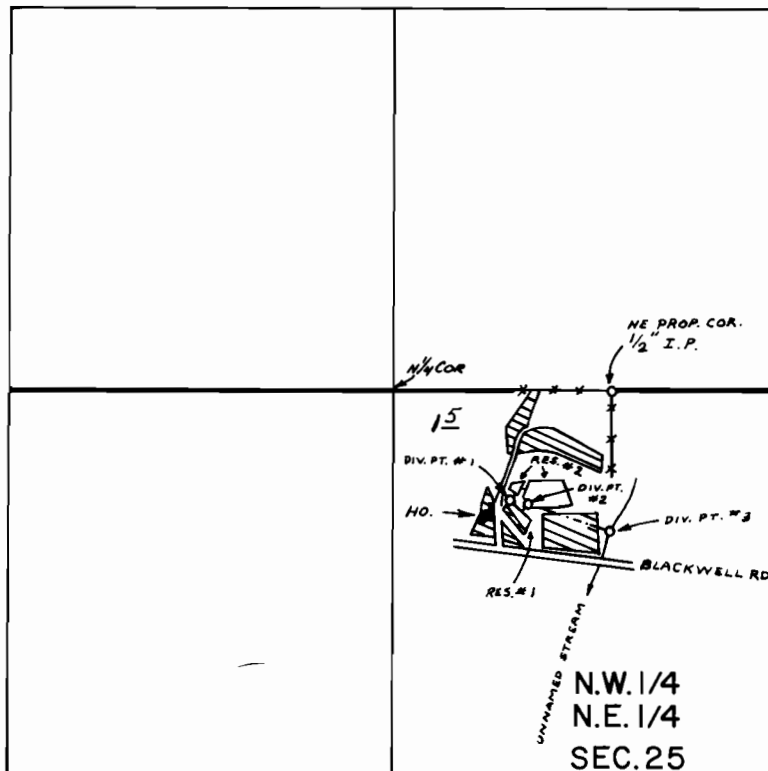

RES. #1 DIV. PT. LOC. : 370' S. & 400' E. FROM N 1/4 COR. SEC. 25
RES. #2 DIV. PT. LOC. : 380' S. & 460' E. FROM N 1/4 COR. SEC. 25
DIV. PT. #3 : 480' S. & 740' E. FROM N 1/4 COR. SEC. 25

SCALE : 1" = 660 FT.

FINAL PROOF SURVEY
UNDER

R-48872

R-5931

48873

36619

Application No. Permit No.
IN NAME OF

HAROLD OR FAE ELDER

Surveyed NOV. 7 78 by B. SUND
19.....