


T.25S. R.7W. W.M.

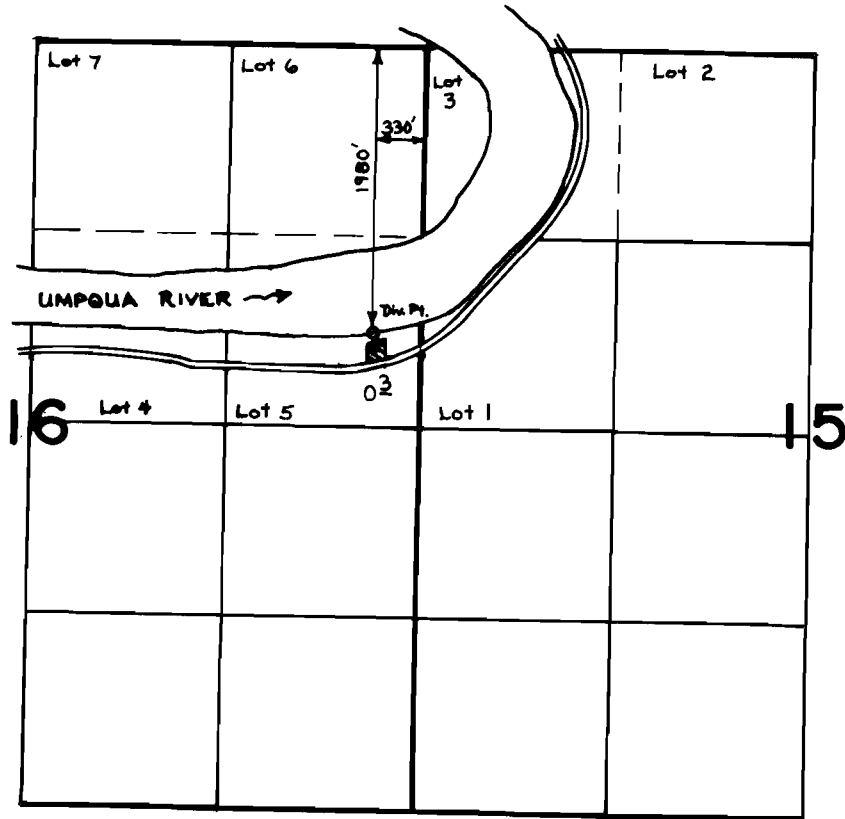

SCALE: 4" = 1 mile

FINAL PROOF SURVEY
UNDER

Application No. 52958 Permit No. 39979...
IN NAME OF

DONALD L. MEIER

Surveyed Nov. 2, 1977, by D. Sparks.....