


T. 35 S., R. 4 W., W. M.

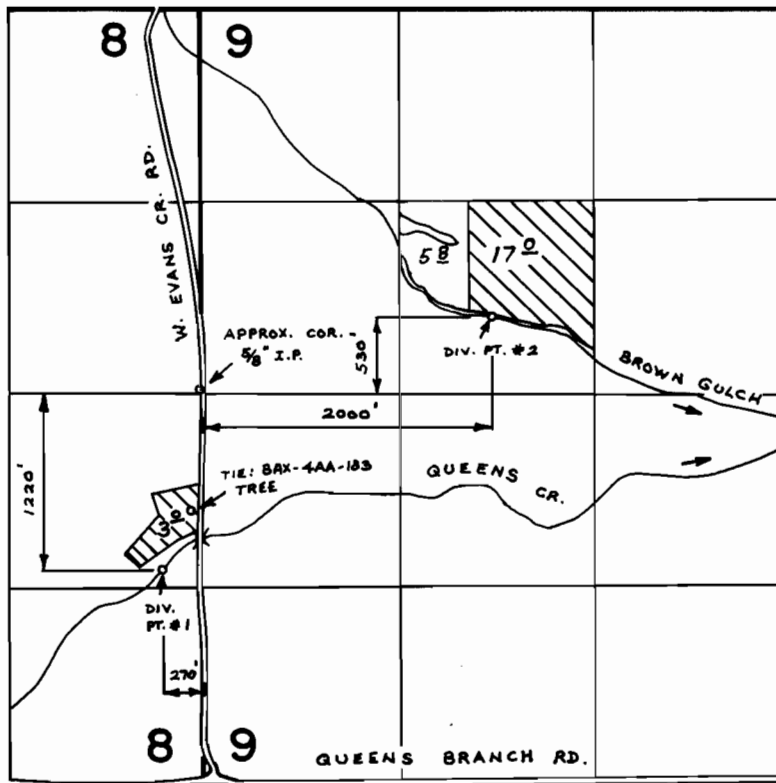

FINAL PROOF SURVEY
UNDER

Application No. 49248 Permit No. 36911

IN NAME OF

CON HOFF

Surveyed NOV. 6 19 78, by B. SUND

D.H.M.
P.T.S. - 1978 - 14 - D
& BAX - 4 AA - 183