


T. 39 S., R. 3 W., W.M.

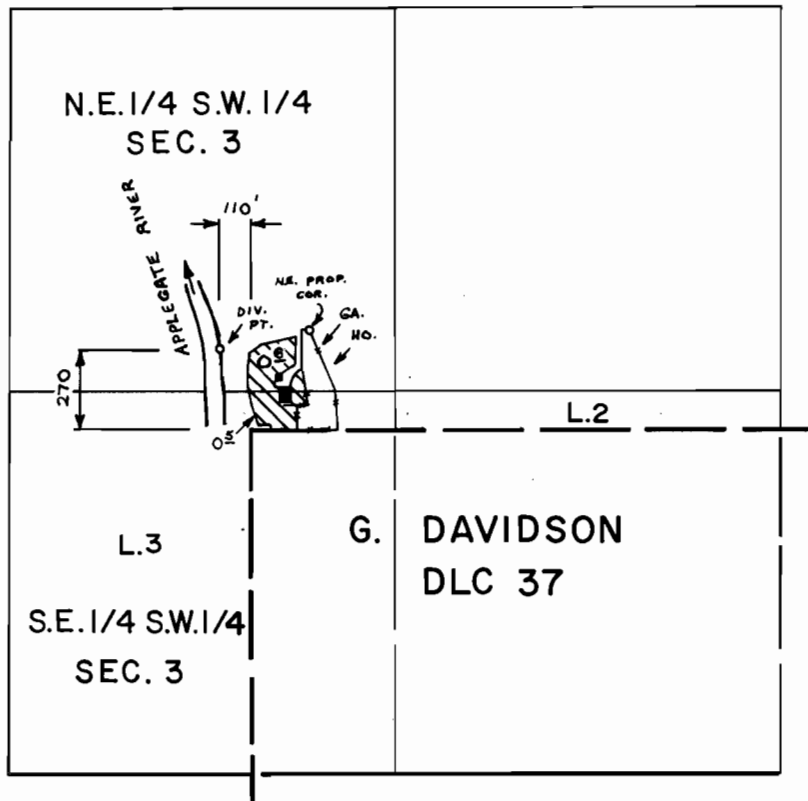

SCALE: 1" = 660 FT.

FINAL PROOF SURVEY UNDER

Application No. 49210 Permit No. 36889
IN NAME OF

WILLIAM J. KEEVER

Surveyed OCT. 13 1978, by B. SUND

D.H.M.
P.T.S.-1978-14-D