


T. 34 S., R. 1 W., W.M.

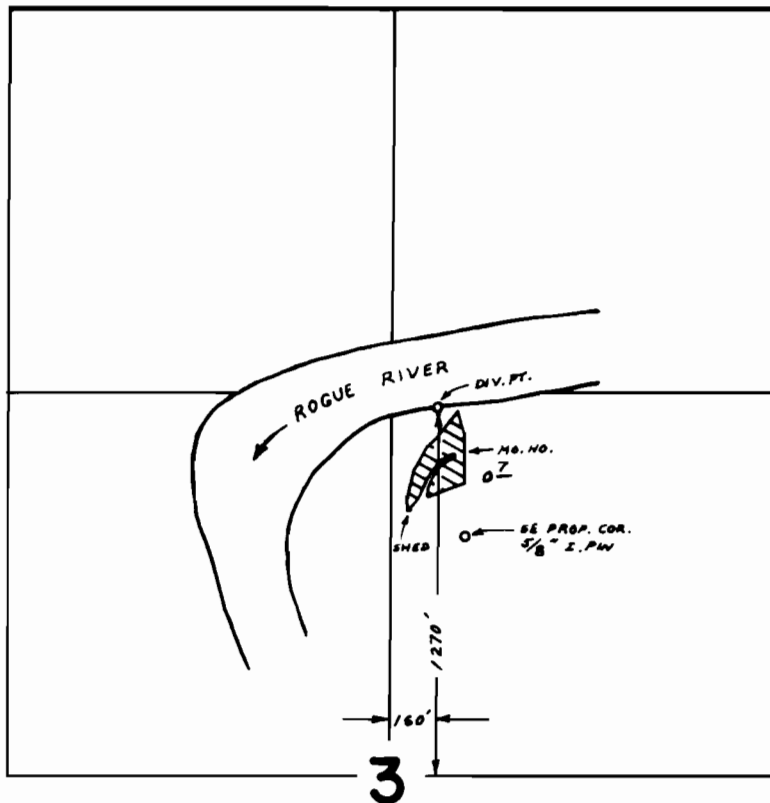

Scale 1" = 660'

FINAL PROOF SURVEY UNDER

Application No. 49345 Permit No. 36992
IN NAME OF

VESTAL & ALIENE N. BLOXHAM

Surveyed AUG. 30 1978 by B. SUND