


T. 39 S., R. 8 W., W.M.

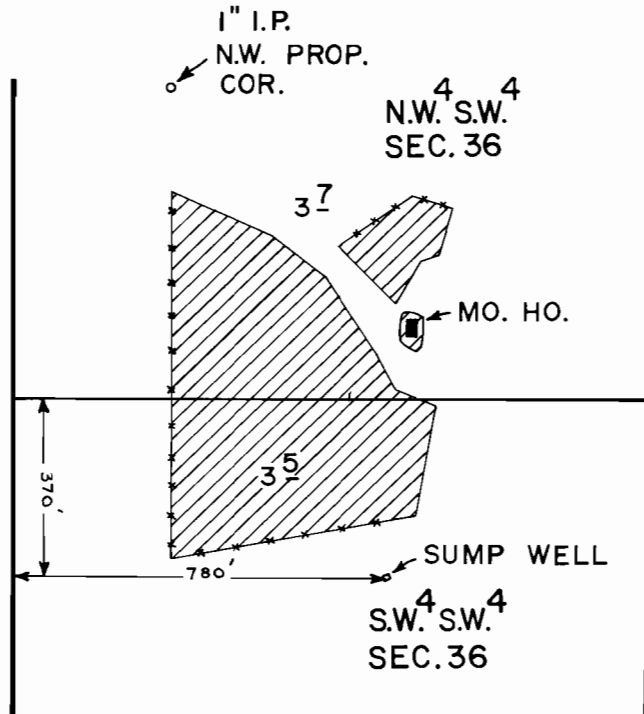

SCALE: 1" = 400 FT.

FINAL PROOF SURVEY UNDER

Application No. G-8002 Permit No. G-7419

IN NAME OF

J. GUY DICK

Surveyed APR. 28 1980, by B. SUND

D.H.M.
P.T.S. - 1980 - 14 - A