


T.36 S., R.7W., W.M.

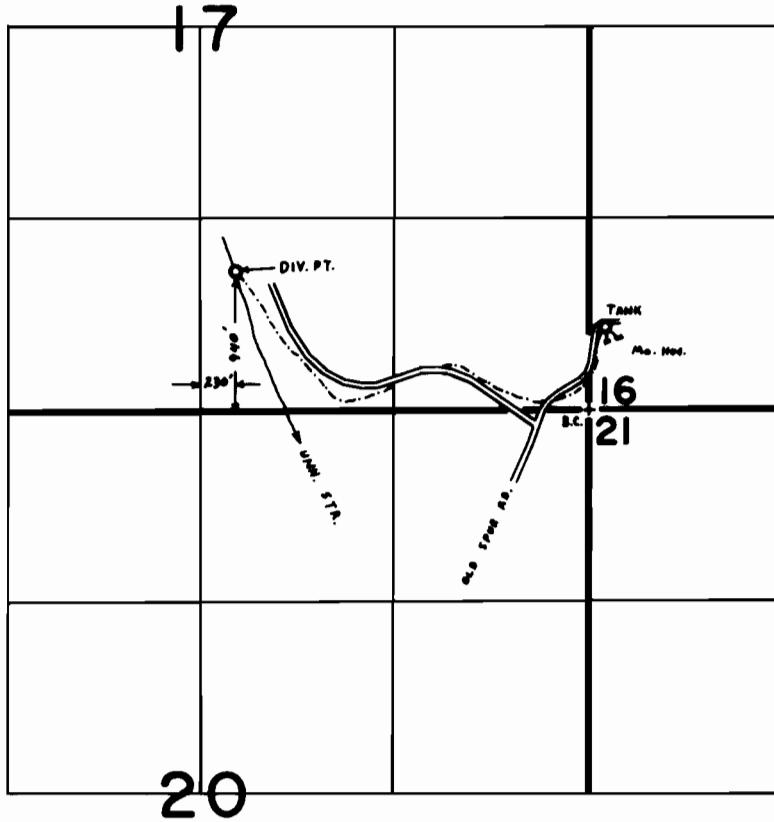

FINAL PROOF SURVEY
UNDER

Application No. **58059**. Permit No. **43739**...
IN NAME OF

MILDRED SPOMER & HELEN BARR

Surveyed **Feb. 15**, 19**80**, by **B. R. SUND**.....