


# T. 35 S., R. 6 W., W.M.

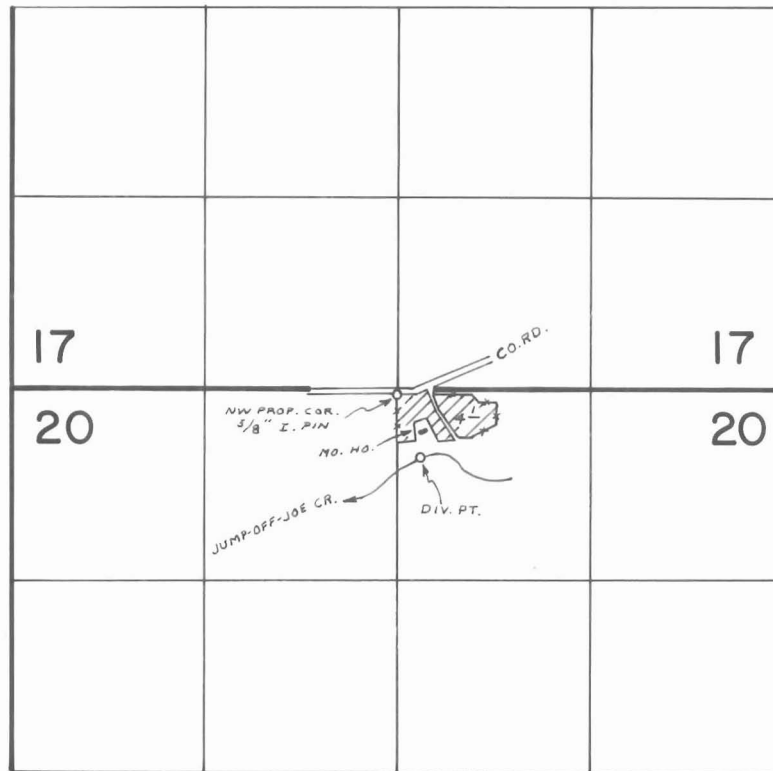

DIV. PT. LOC.: 480'S. & 160'E FROM N<sup>1</sup>/<sub>4</sub> COR. SEC. 20

## FINAL PROOF SURVEY UNDER

Application No. 49560 Permit No. 37094

IN NAME OF

JOHN C. & EDITH A. STILLMAN

Surveyed NOV. 2 77 by B. SUND  
19.....