


T.36 S., R. 6 & 7 W., W.M.

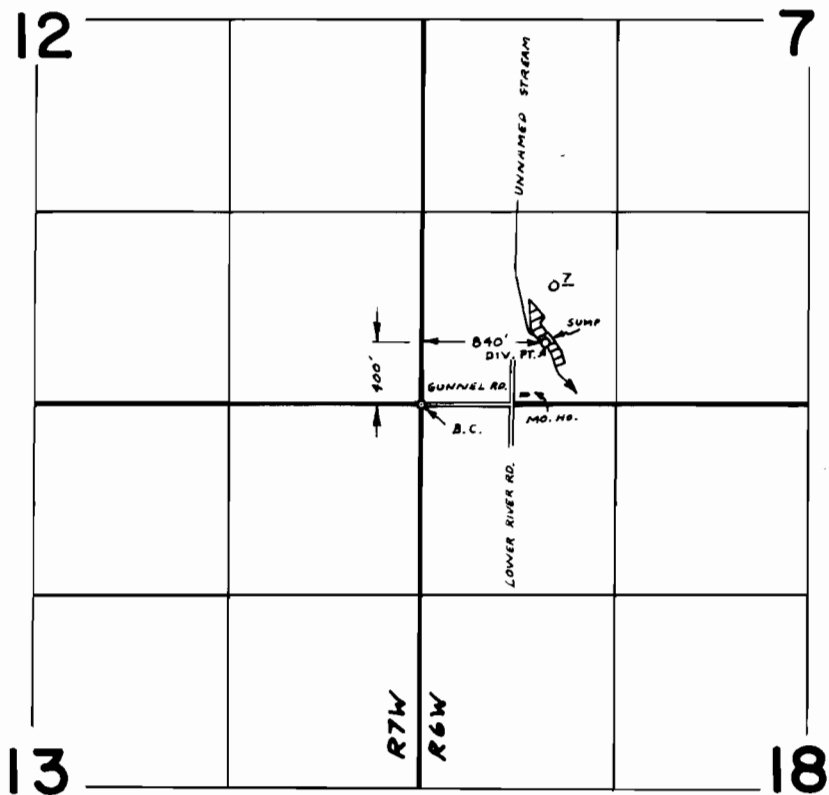

FINAL PROOF SURVEY
UNDER

Application No. 48635 Permit No. 36481
IN NAME OF

ORAL & MIDGE L. LORDS

Surveyed NOV. 14 1977 by B. SUND