


T. 35 S., R. 7 W., W.M.

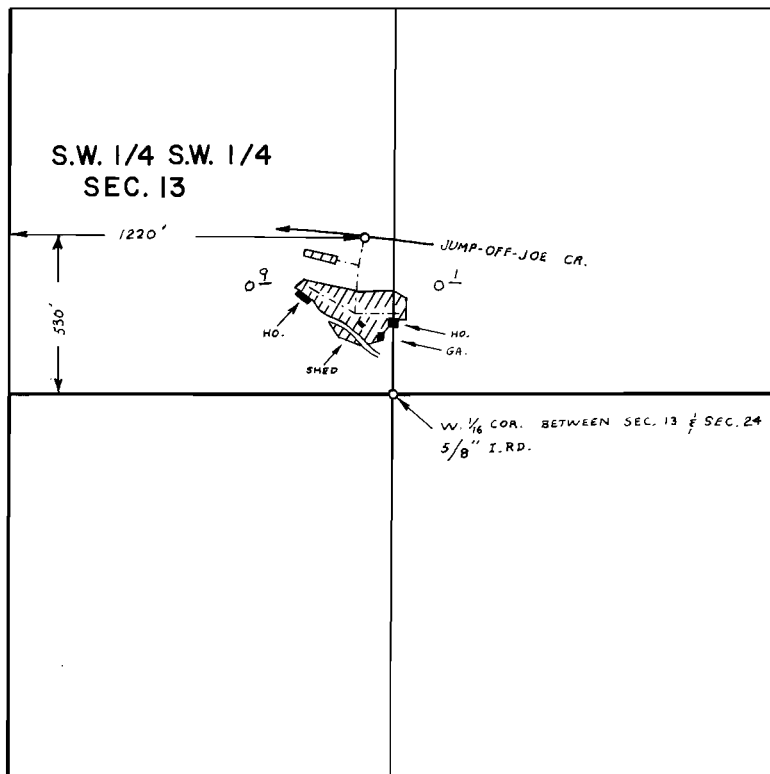

SCALE: 1" = 660 FT.

FINAL PROOF SURVEY UNDER

Application No. 50413 Permit No. 38046

IN NAME OF

WILLA B. WARREN

Surveyed NOV. 18 1977, by B. SUND