


T.36 S., R.5 W., W.M.

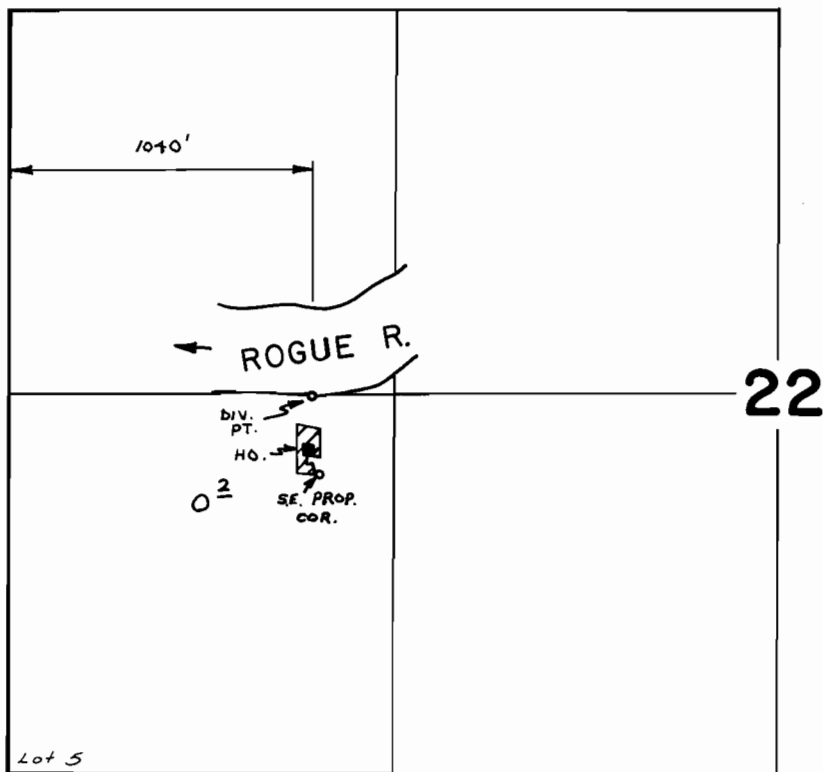

SCALE: 1" = 660 FT.

FINAL PROOF SURVEY
UNDER

Application No. 51833 Permit No. 39031
IN NAME OF

OSWALD STAUTZ

Surveyed SEPT. 20 1977, by B. SUND