


T.35 S., R.7 W., W.M.

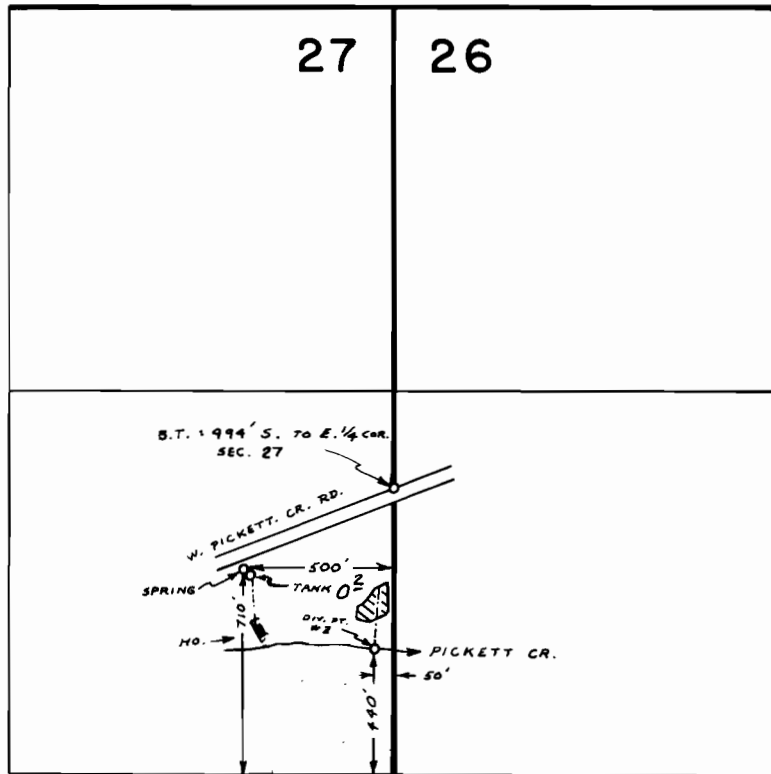

SCALE: 1" = 660 FT.

FINAL PROOF SURVEY UNDER

Application No. 52775 Permit No. 39842
IN NAME OF

DAVID F. & DIANE E. STOCKTON

Surveyed AUG. 10 1978, by B. SUND