


T.18S. R.41E. W.M.

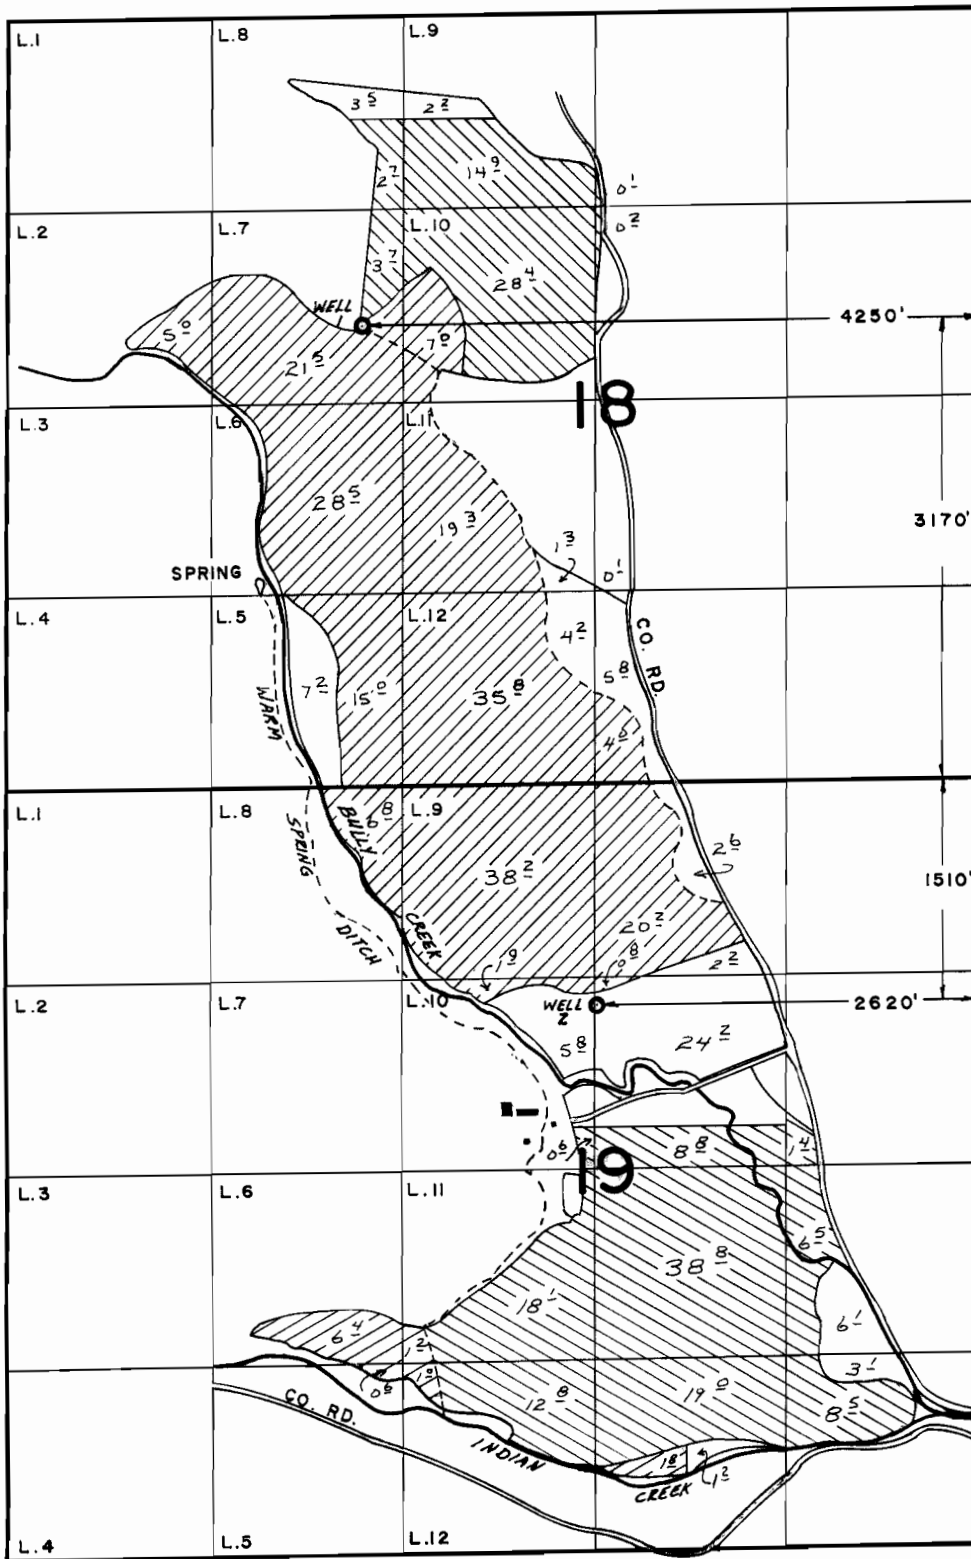

FINAL PROOF SURVEY

UNDER

Application No. G-5104 G-4816
Permit No. G-5103 G-4815

IN NAME OF

AMICK & Sons

Surveyed June 28, 1978 by L.H. NUNN

Primary



Suppl

