


# T. 9S. R. 3E., W.M.

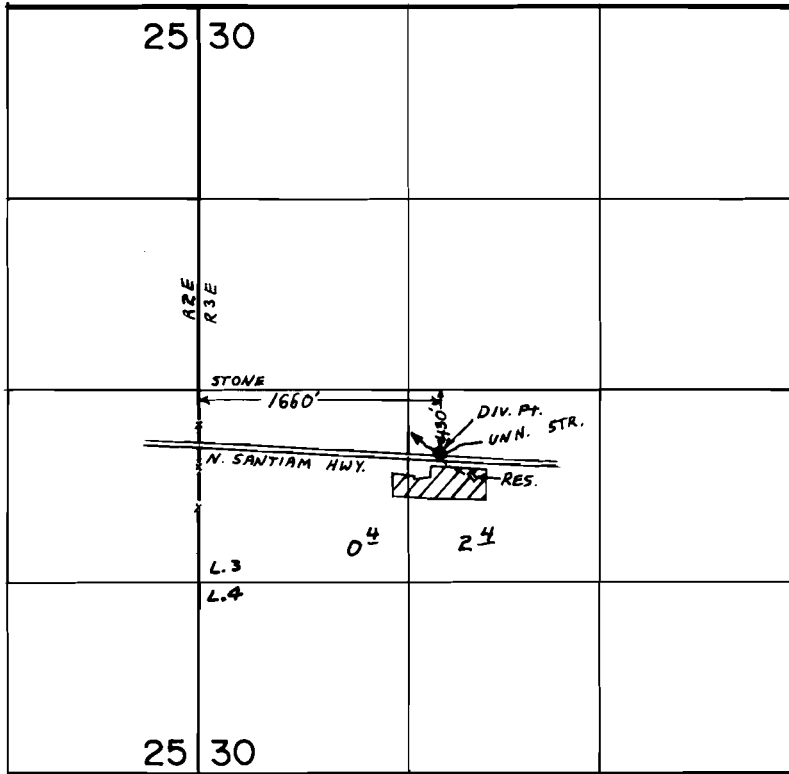

## FINAL PROOF SURVEY UNDER

R-56390                      R-6639  
 Application No. 56391      Permit No. 41968  
 IN NAME OF

.....DERREL E. ANDERSEN.....

Surveyed MAY 22, 1978, by S. P. APPLGATE