


T.9S. R.3E., W.M.

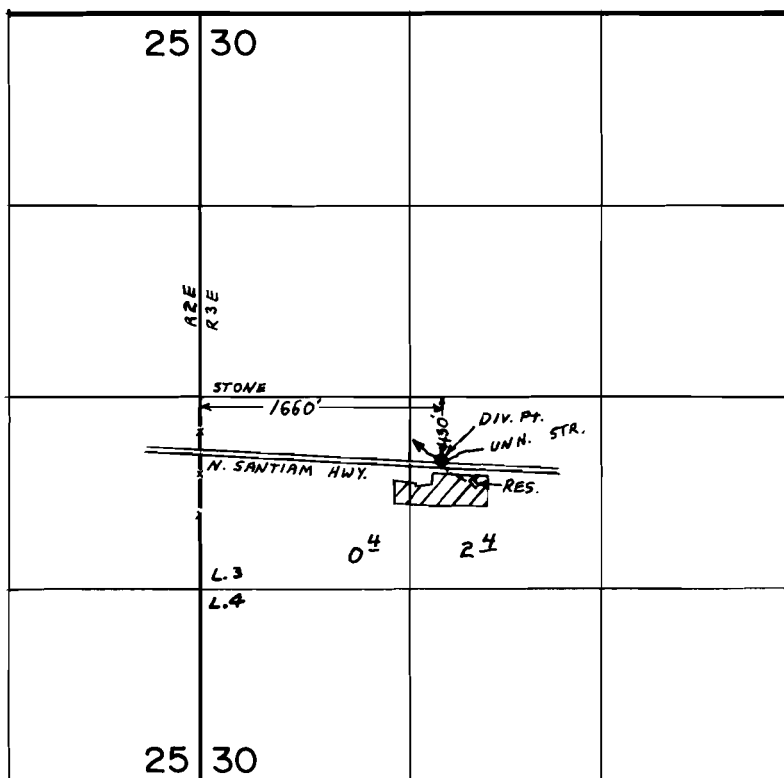

FINAL PROOF SURVEY UNDER

R-56390 R-6639
 Application No. 56391 Permit No. 41968
 IN NAME OF

DERREL E. ANDERSEN

Surveyed MAY 22, 1978, by S.P. APPLEGATE