


T. 15. R. 32E. W.M.

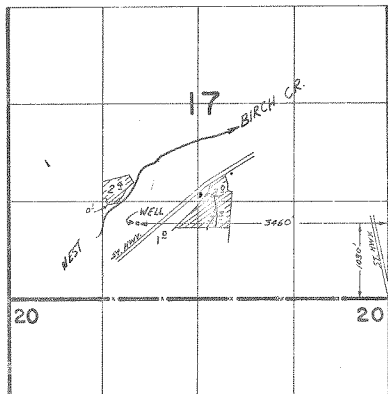

FINAL PROOF SURVEY
UNDER

Application No. G-5968 Permit No. G-5729
IN NAME OF

RALPH J. HUTCHISON

Surveyed 10-9-1977, by R. BARWIN