

T.5N.,R.26E.,W.M.

G-6032


49560

49559

RECORDED

SEP 05 1980

WATER RESOURCES DEPT
SALEM, OREGON

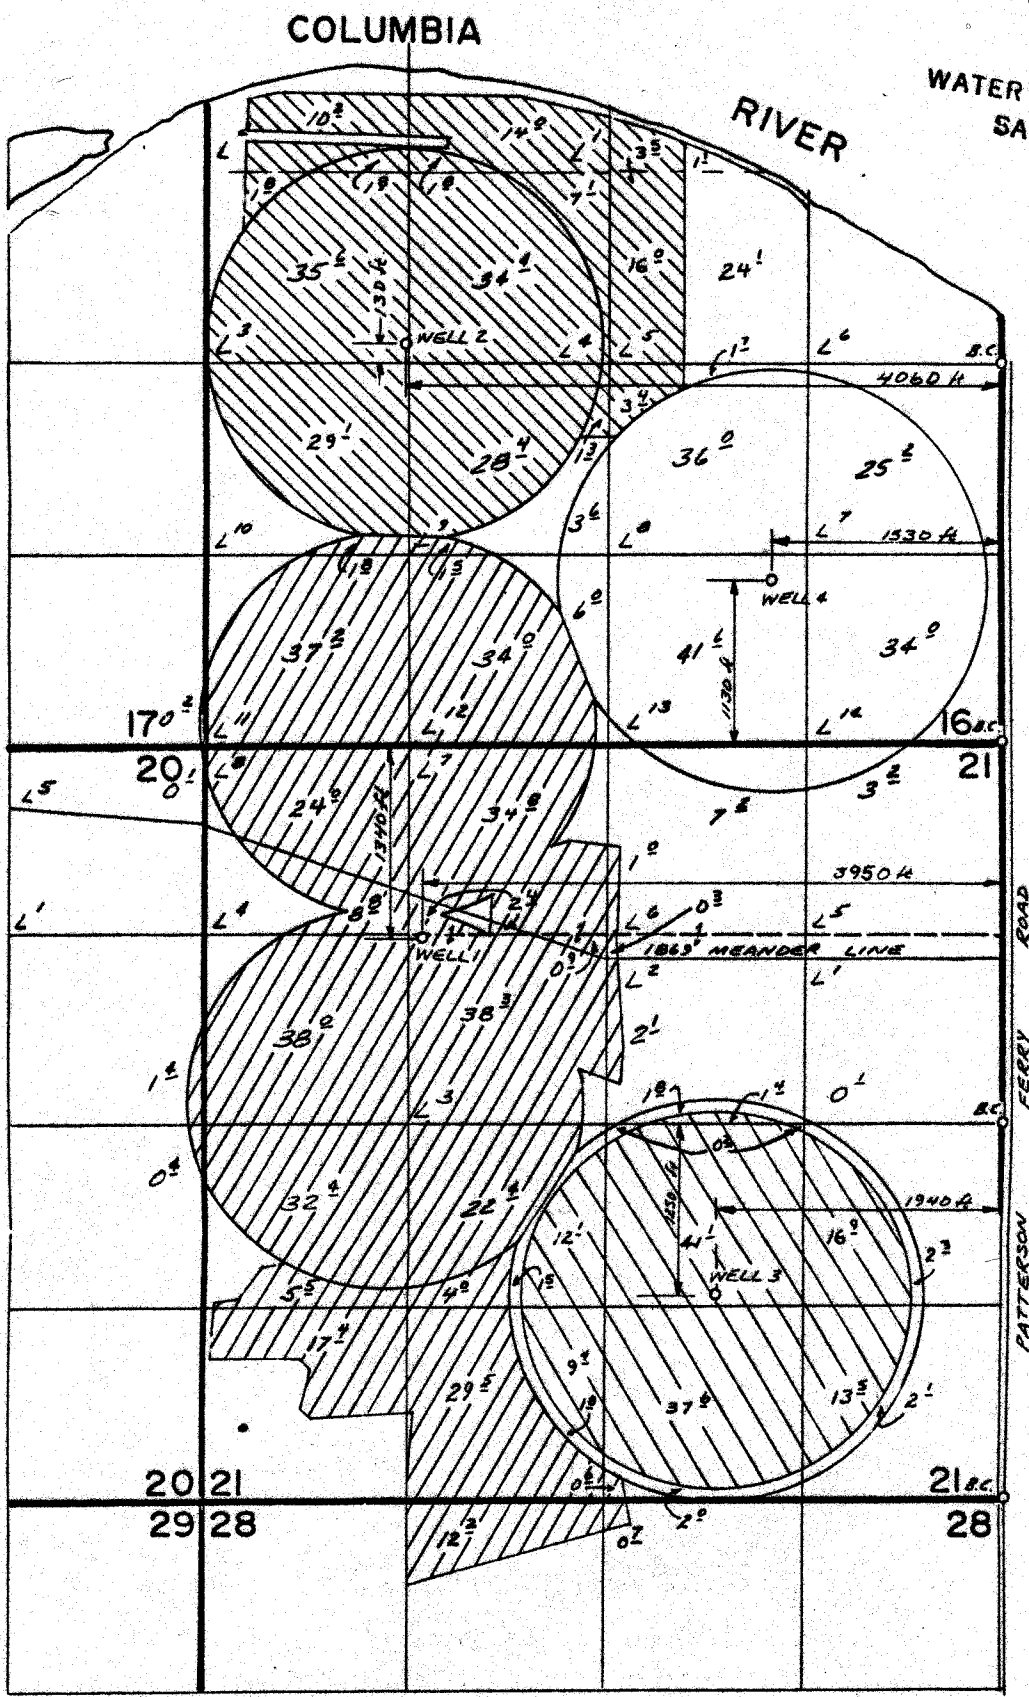


FINAL PROOF SURVEY

UNDER

APPL. G 6013 PER. G 5159



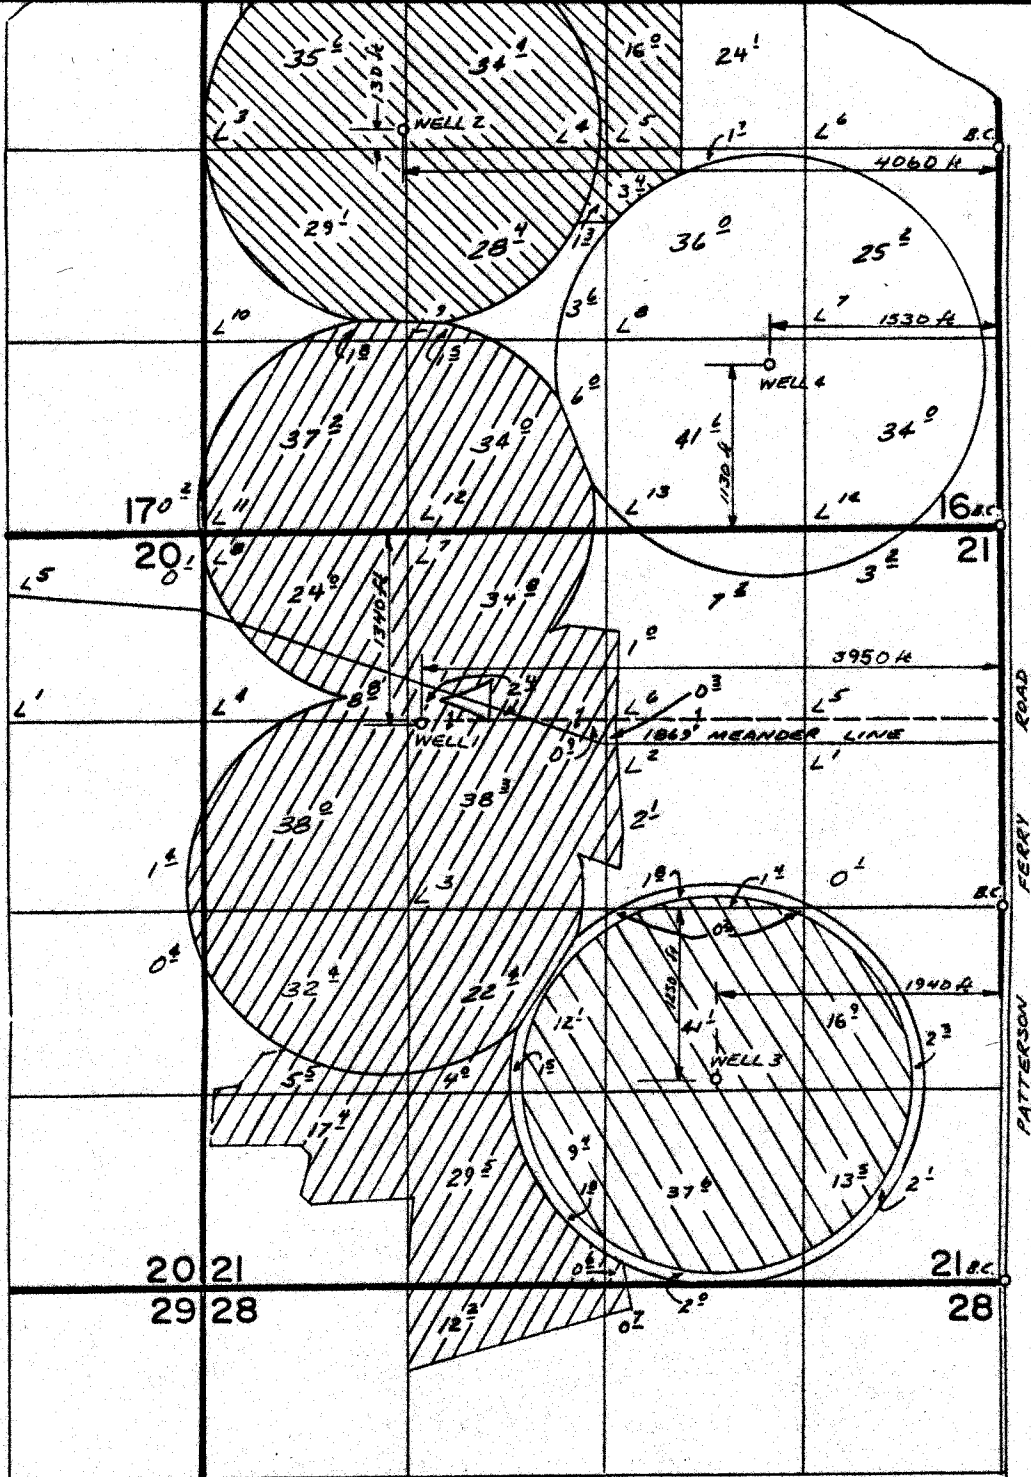


FINAL PROOF SURVEY

UNDER

APPL. G 6013 PER. G 5159

G 6569 G 6031

G 6570 G 6032

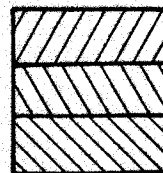

IN NAME OF

U.S. FISH & WILDLIFE SERVICE

SURVEYED JULY 28, 1976 by L. H. MUNN
 APRIL 11, 1978 by R. BARWIN