

FINAL PROOF SURVEY

UNDER

APPL. G 6013 PER. G 5159

G 6569 G 6031

G 6570 G 6032



IN NAME OF

U.S. FISH & WILDLIFE SERVICE


SURVEYED JULY 20, 1976 by L. H. NUNN
APRIL 11, 1978 by R. BARWIN

1874-Q

G-6031
G-6032
49560
49559

T.5N.,R.26E.,W.M.

RECEIVED
SEP 08 1980
WATER RESOURCES DEPT
SALEM, OREGON

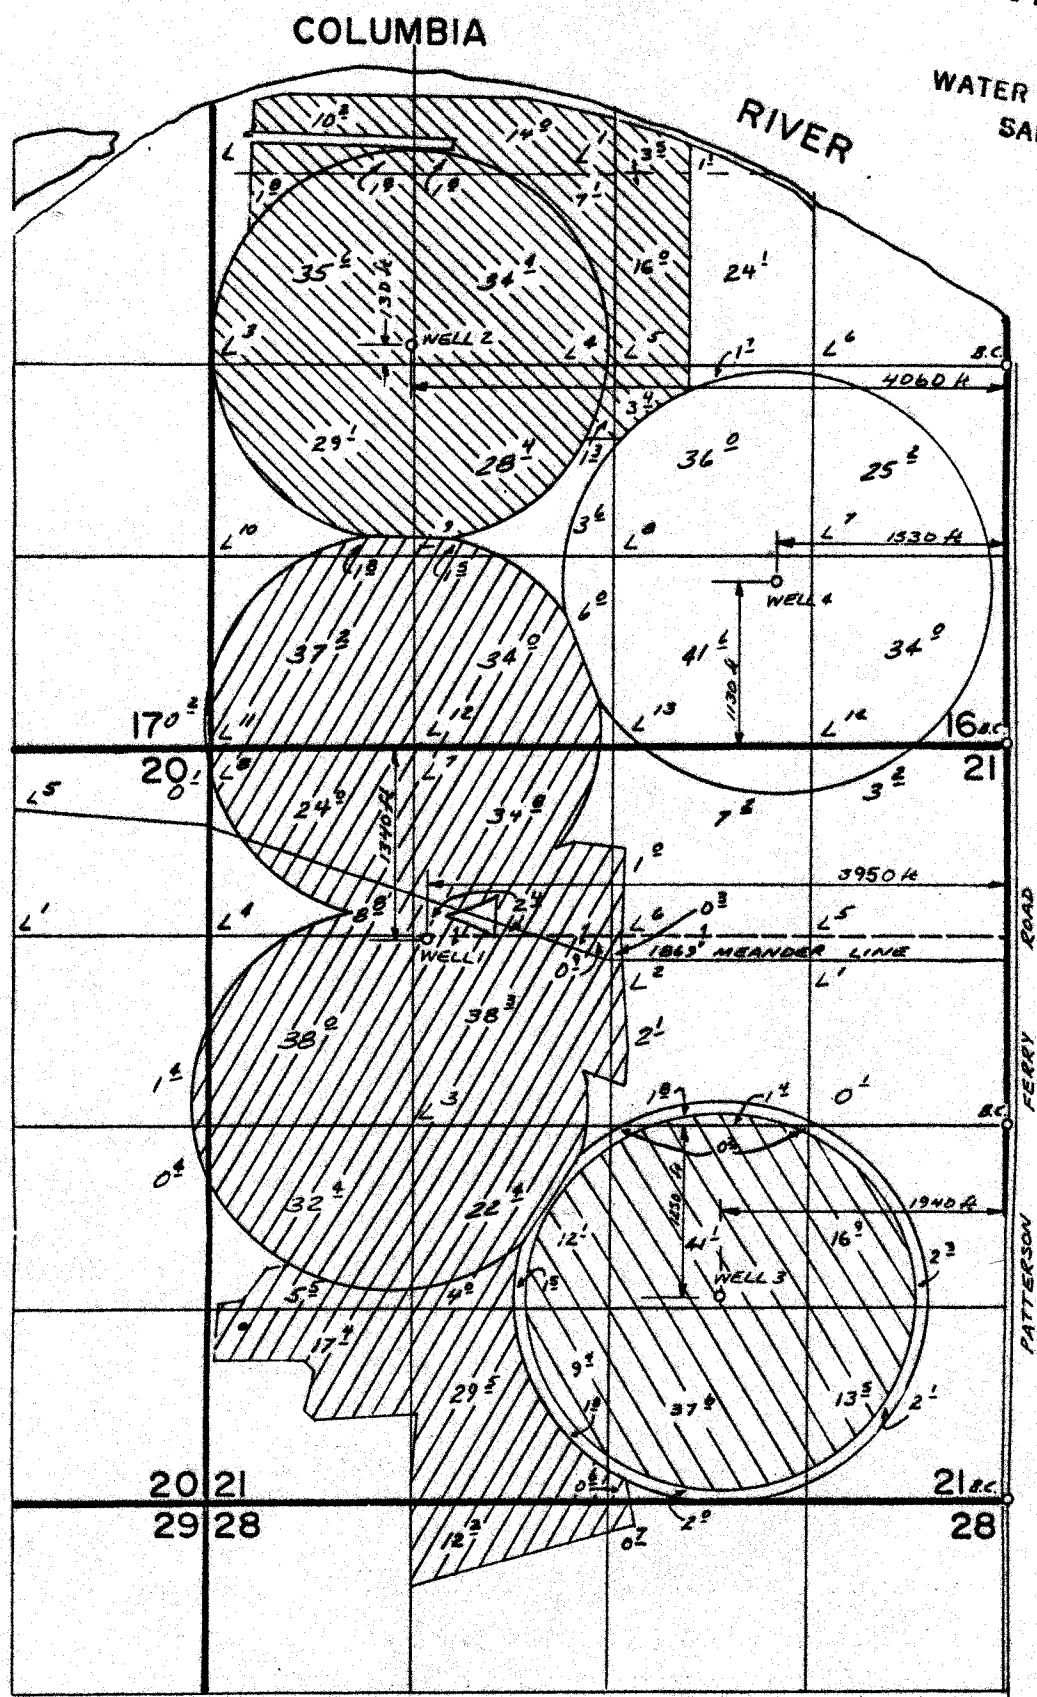

FINAL PROOF SURVEY
UNDER