G-5159
49961

T.5N., R.26E., W.M.

RECEIVED
SEP 05 1980
WATER RESOURCES DEPT
SALEM, OREGON

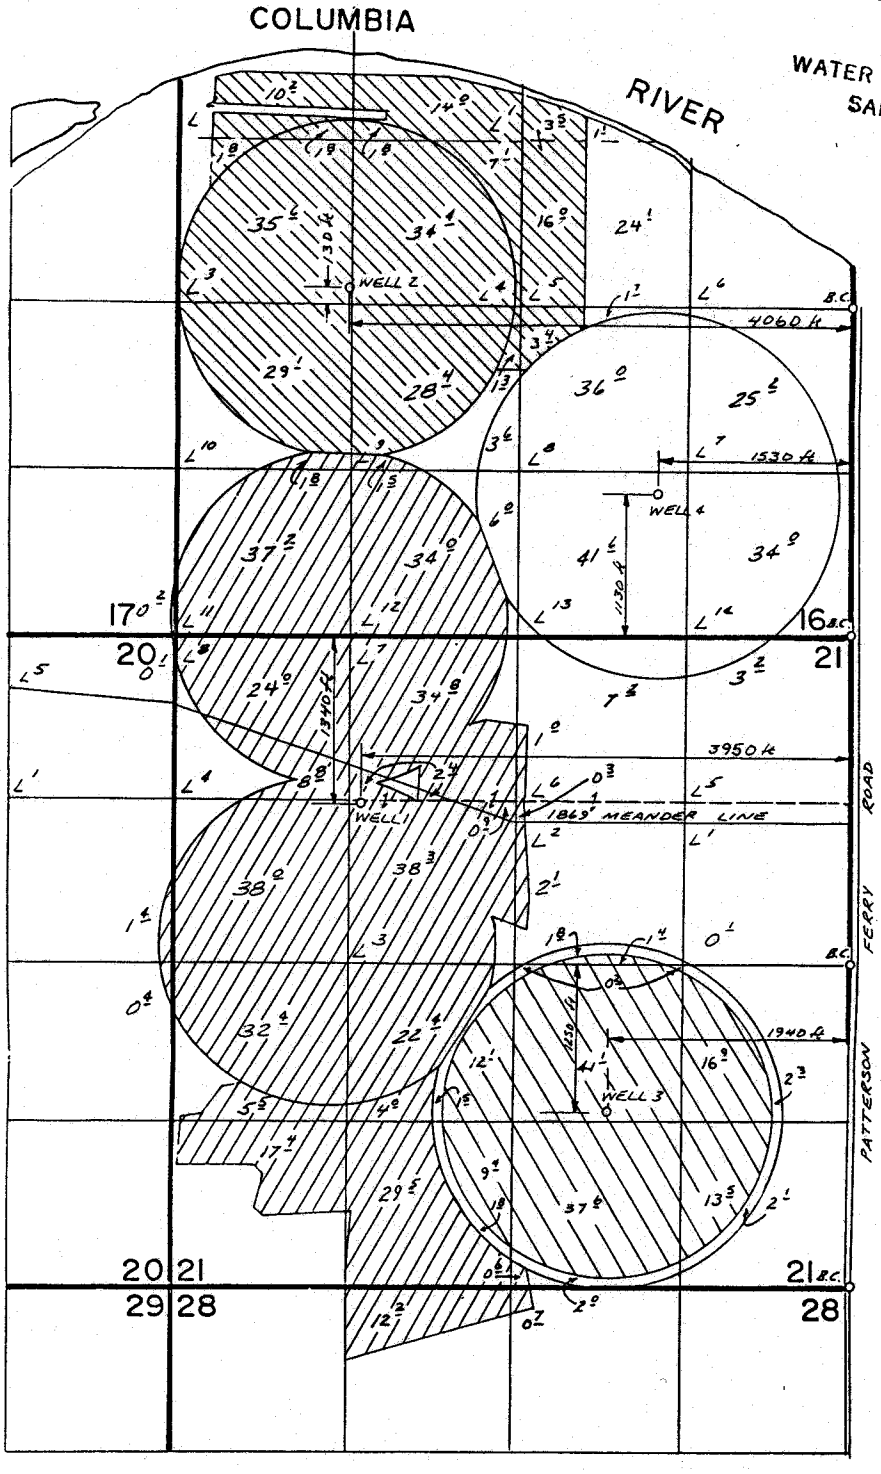

FINAL PROOF SURVEY

UNDER

APPL. G 6013 PER. G 5159
G 6569 G 6031
G 6570 G 6032

IN NAME OF

U.S. FISH & WILDLIFE SERVICE

Surveyed July 28, 1976 by L.H. NUNN
April 11, 1978 by R. Barwin