


T.7S.,R.5W.,W.M.

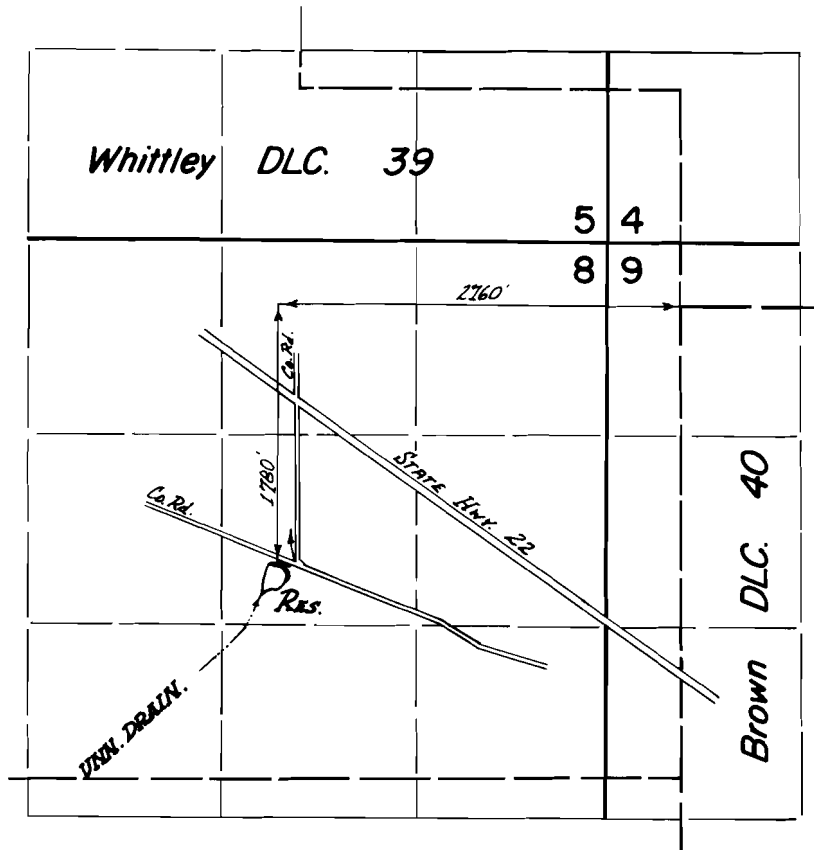

FINAL PROOF SURVEY
UNDER

Application No. R-54006 Permit No. R-6463
IN NAME OF

JAMES S. COATES

Surveyed July 7 1977, by L.M. Tom

ML