


G-6617  
49564

# T. 4N. R. 28E. W.M.

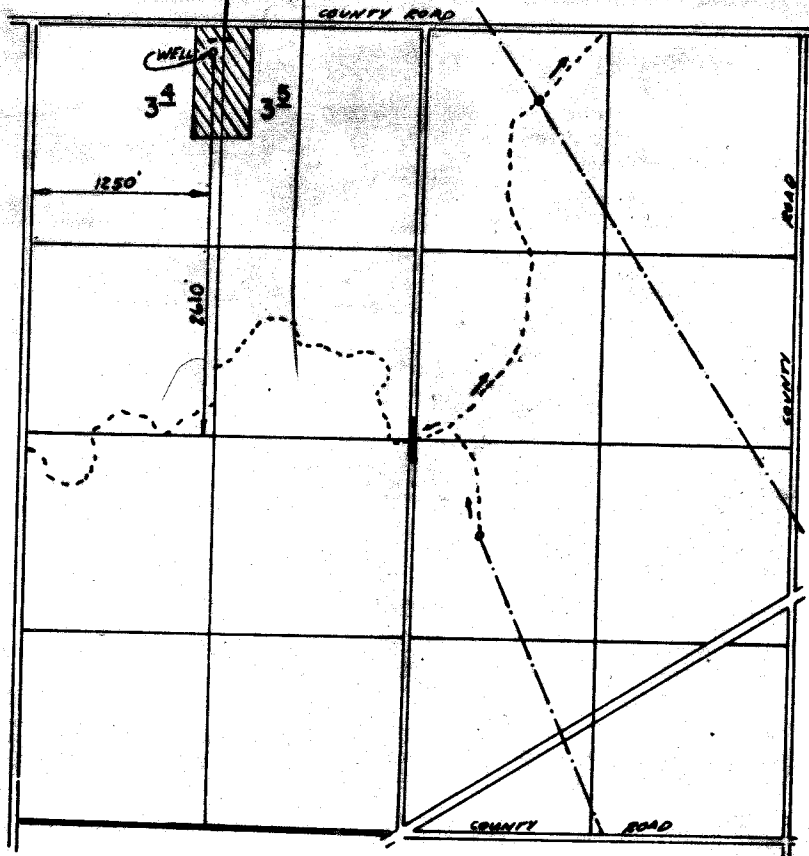

## FINAL PROOF SURVEY UNDER

Application No. G-7185 Permit No. G-6617  
IN NAME OF

THEODORE L. ISSEL

Surveyed 2-9 1972, by V. Chuch