


T.6S. R.1W., W.M.

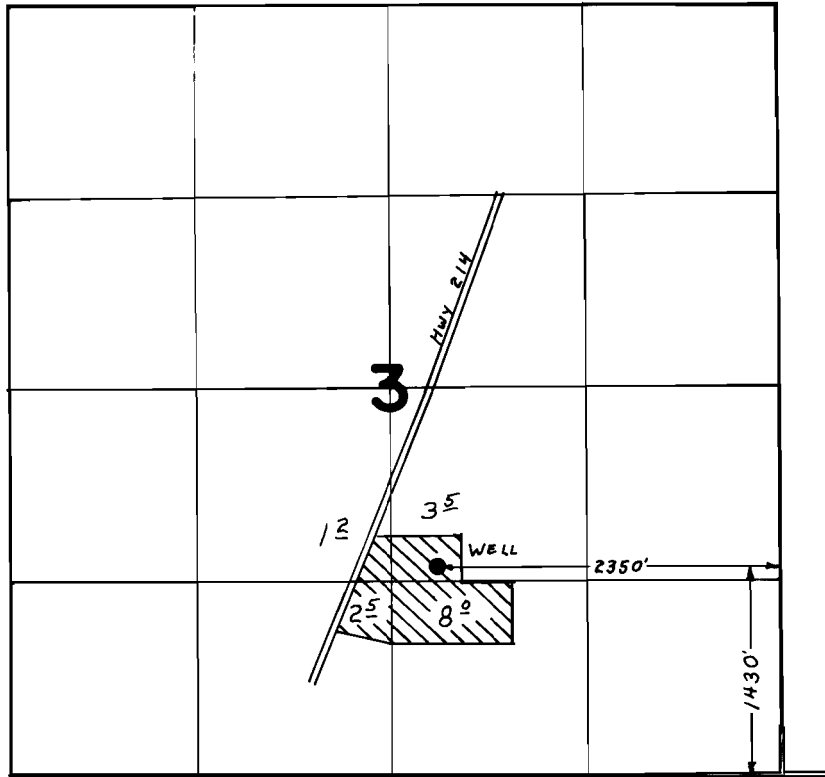

FINAL PROOF SURVEY UNDER

Application No. G-7048 Permit No. G-6535
IN NAME OF

CALVARY CEMETERY ASSOC.

Surveyed MAR. 16, 1978, by S.P. APPLIGATE