


T. 15 S., R. 5 W., W.M.

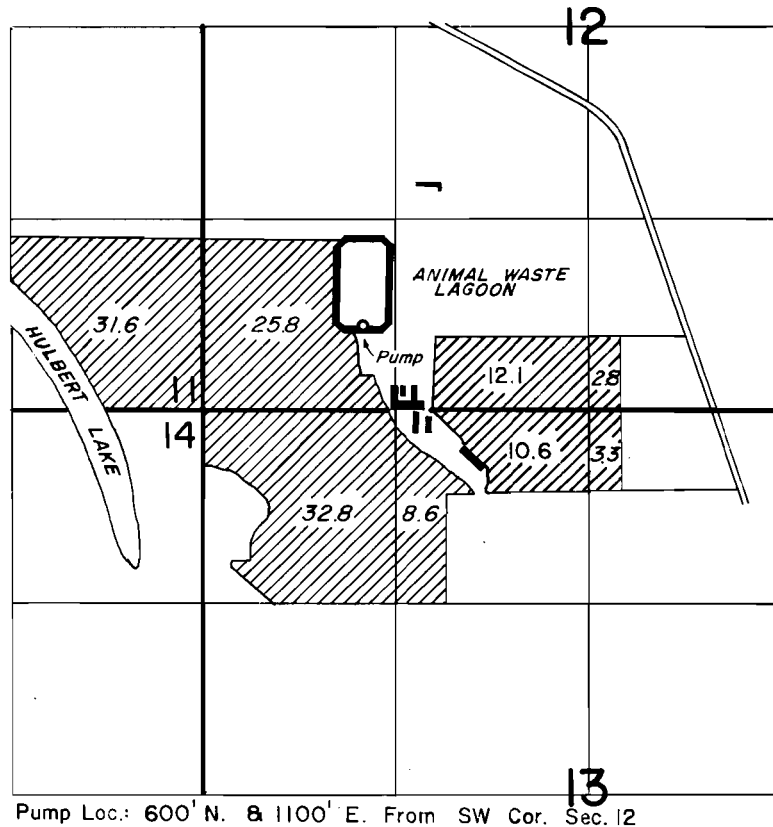

FINAL PROOF SURVEY
UNDER

R-52263 R-6093
Application No. 52264 Permit No. 37547
IN NAME OF

GIBSON & GIBSON

Surveyed MAY 25, 1978, by L. NUNN