


T. 3N. R. 33E. W.M.

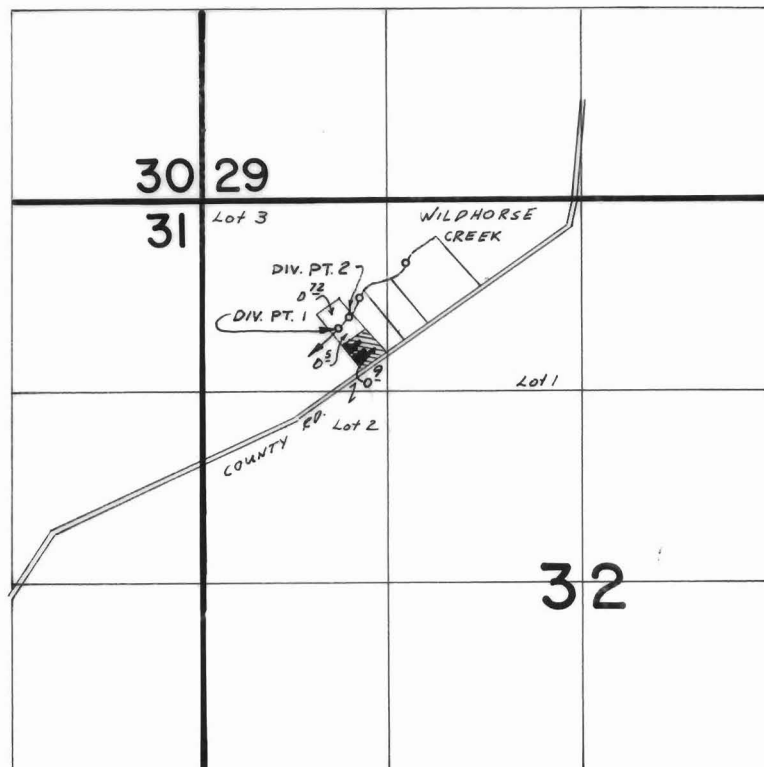

DIV. PT. 1 LOC. 870'S $\nearrow$ 930'E FROM NW COR SEC. 32
DIV. PT. 2 LOC. 800'S $\nearrow$ 1000'E FROM NW COR SEC. 32

FINAL PROOF SURVEY
UNDER

TRANSFER 3922

Application No. 57634 Permit No. 43398
IN NAME OF

.....RAYMOND FARMER.....

Surveyed 3-2 1979, by R. BARWIN