


T.3S. R.40E. W.M.

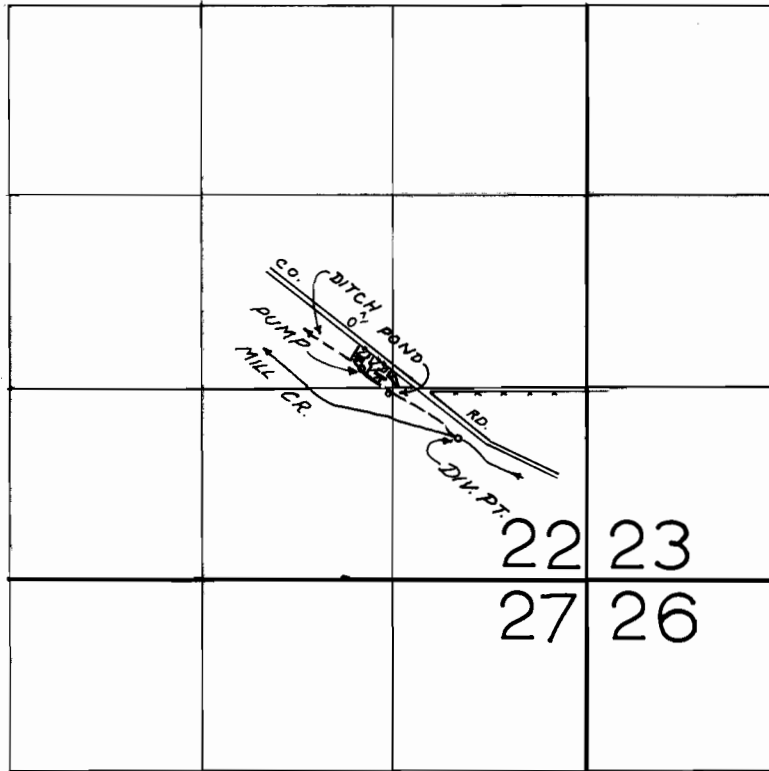

PUMP LOCATED 175' W & 120' N FROM SE COR OF NW 1/4 OF SE 1/4 OF SEC 22
POND LOCATED 50' W & 20' S FROM NE COR OF SW 1/4 OF SE 1/4 OF SEC 22
DIV. PT. LOCATED 450' E & 320' S FROM NW COR. OF SE 1/4 OF SE 1/4 OF SEC 22

FINAL PROOF SURVEY
UNDER

Application No. 52413... Permit No. 39423...

IN NAME OF

MILLARD A. & DOROTHY Y. GIBBONS
EDWARD G. & JEANETTE D. BAUMAN

Surveyed OCT. 18... 1977, by R. BARWIN.....

R. Barwin