

Grant

STATE OF OREGON


COMMITTEE
Chairman: Public Lands
Members: Fishing Industries
Horticulture

THIRTY-FIRST LEGISLATIVE ASSEMBLY

SENATE CHAMBER

SALEM

13a
OFFICE OF STATE ENGINEER
RECEIVED
FEB 12 1921
SALEM, OREGON

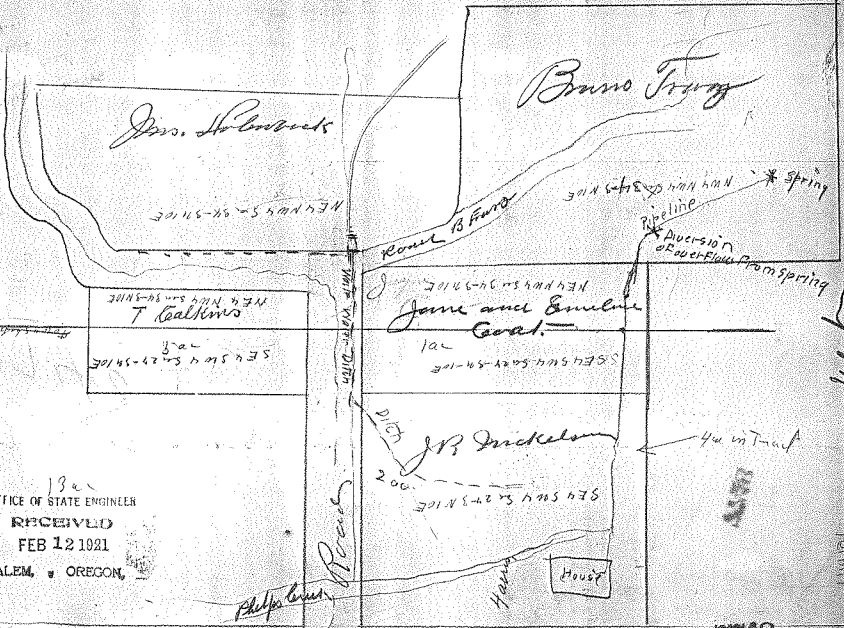

How soon it will

Scath

Columbia Highway

Application No. 7748
Permit No. 4961

Walt

Permit 4961

Sec. 27


26

3

34

Tp. 3N

R. 10W

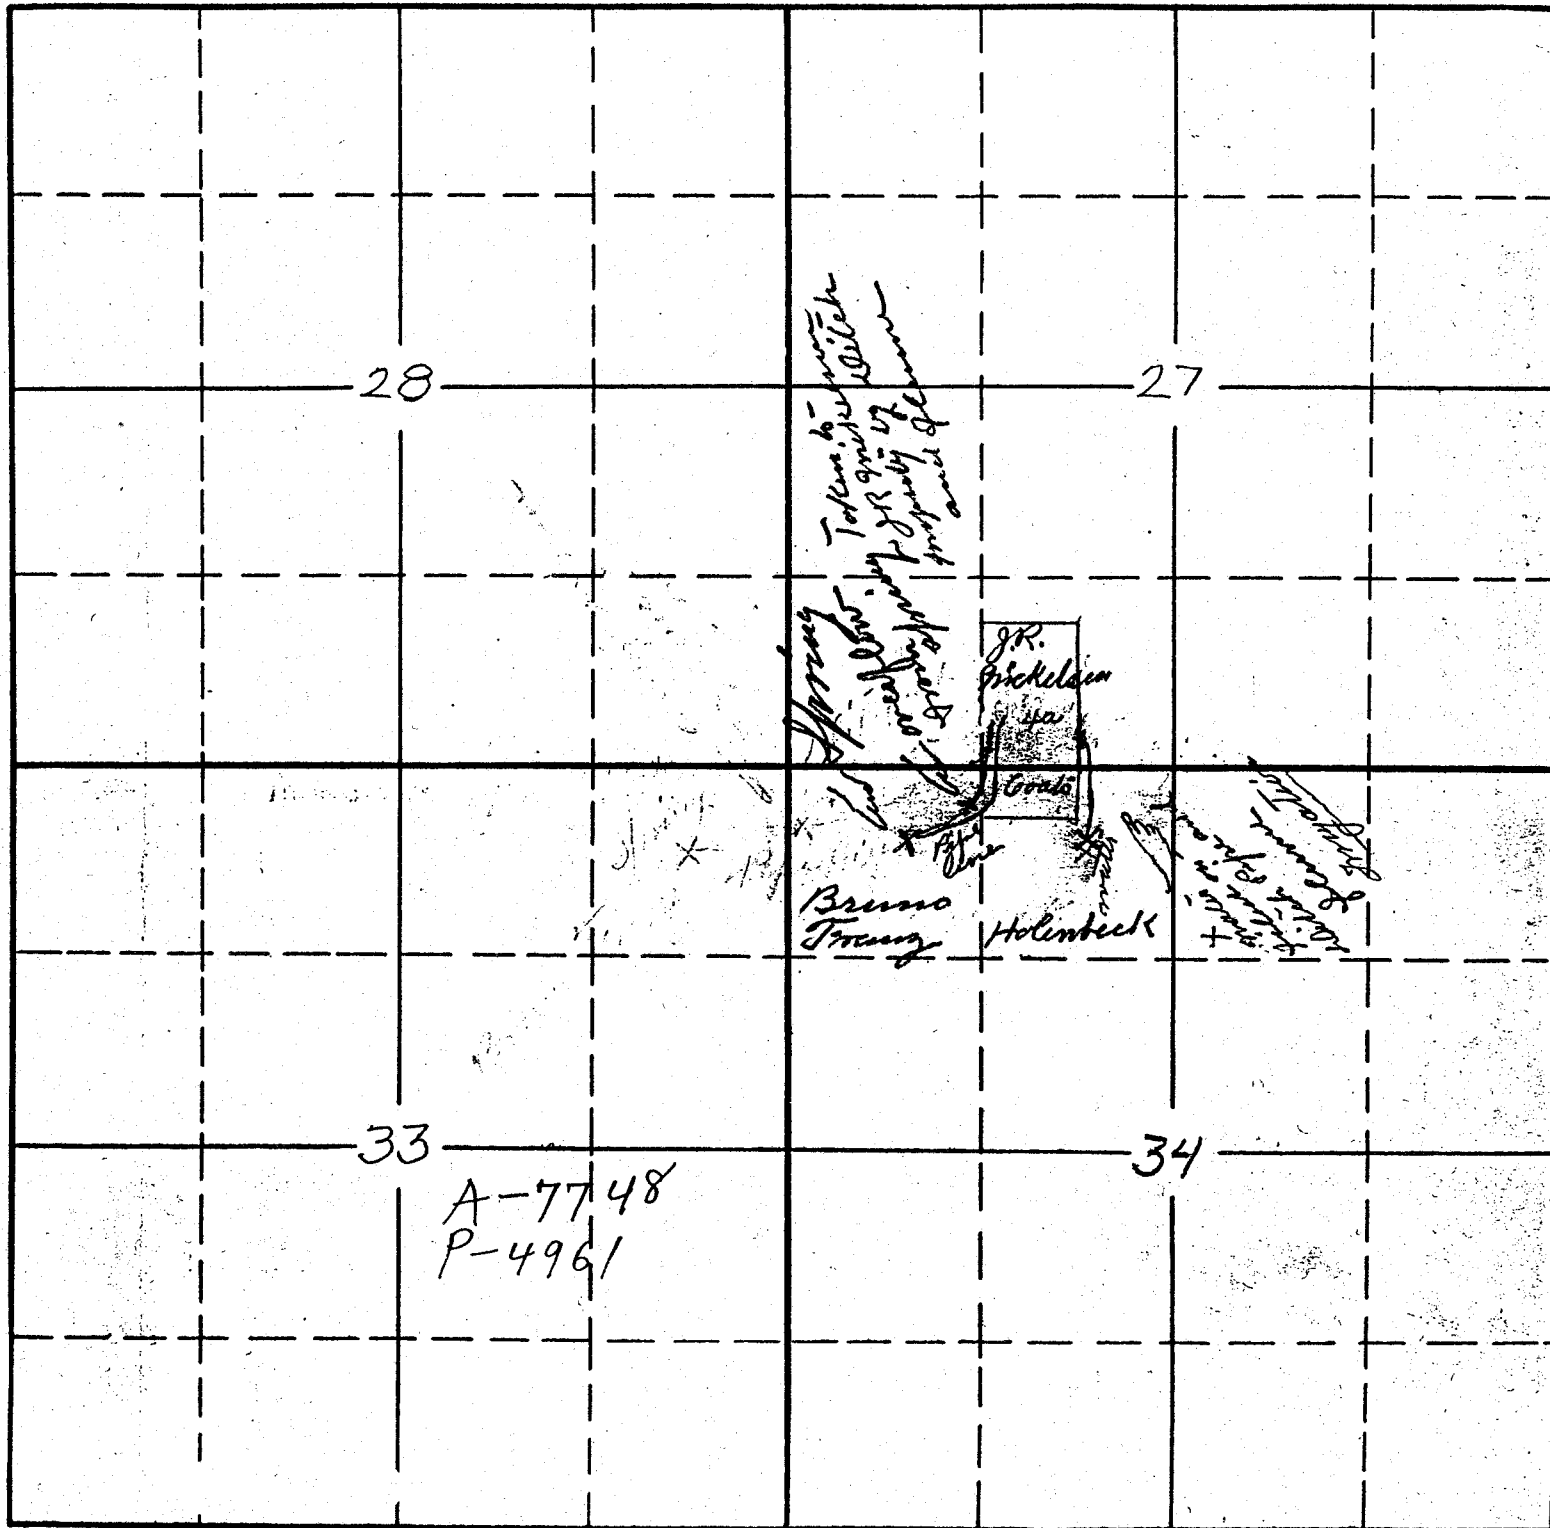

W. Rickelden
 Gonda