



DOMESTIC WATER SYSTEM OF R. B. SMITH GRIZZLY ORE. Scale 1 inch = 200 feet 14

8027

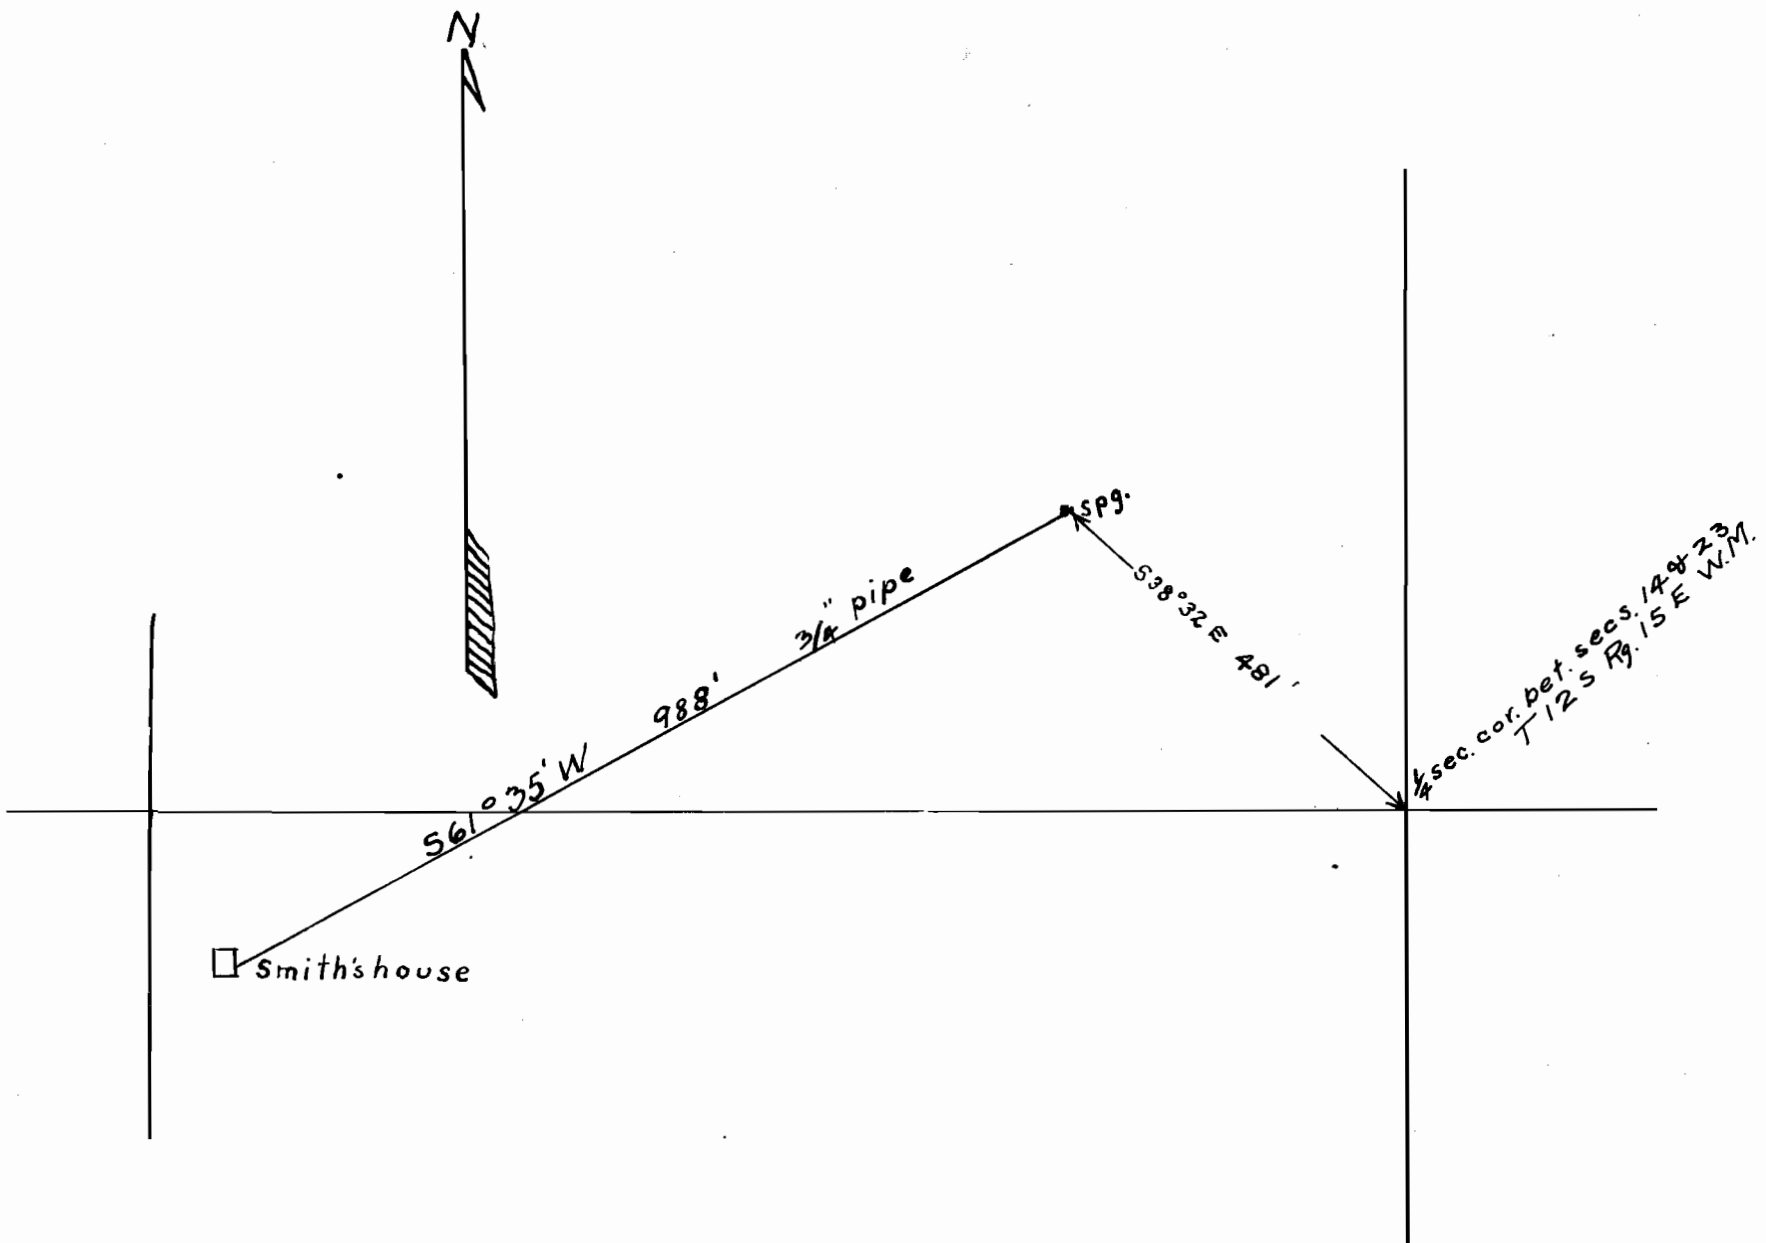

I Raymond G. Heider of Madras Oregon do hereby certify that this map was made from notes taken by me on June 20 1920, and that it correctly represents the works described in the accompanying application together with the location of streams and other ditches in the immediate vicinity.

Raymond G. Heider
County Engineer

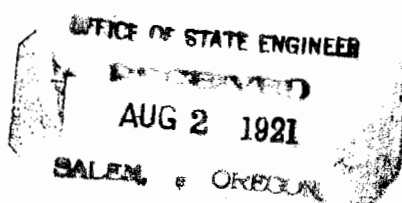

Application No. 8027
Permit No. 5157