


T.4S. R.1E. W.M.

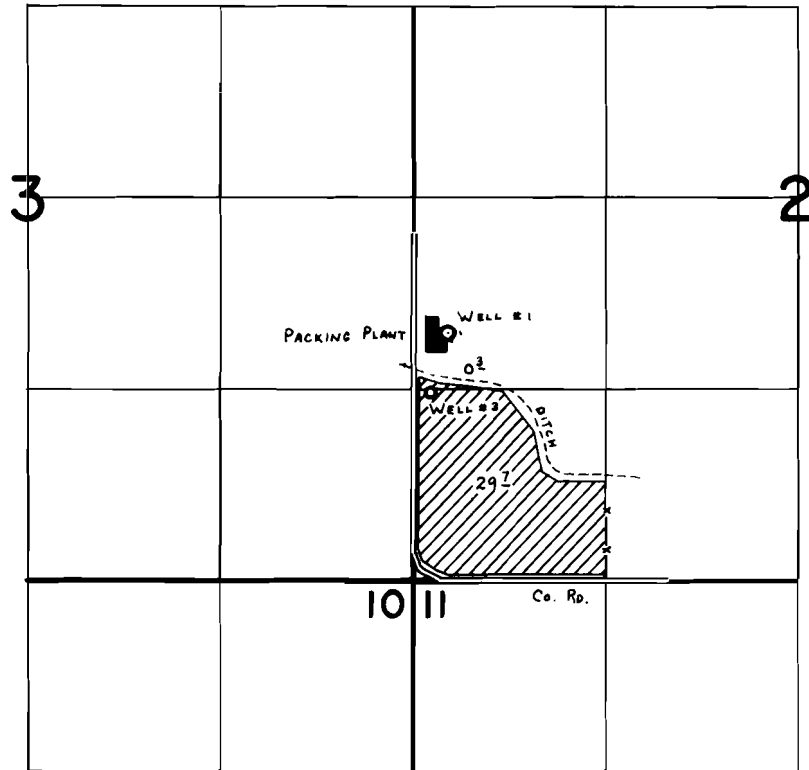

WELLS LOC:
#1 - 1700' N. & 240' E. }
#3 - 1280' N. & 120' E. } Both FROM S.W. COR. SEC. 2.

FINAL PROOF SURVEY UNDER

G-5692 G-8348
Application No. ~~G-5693~~ Permit No. ~~G-8349~~
IN NAME OF

WEBBER & SONS, INC - JOHN C. WEBBER

Surveyed Oct. 10, 1979, by C. L. HUGHES