


T.4S. R.1E. W.M.

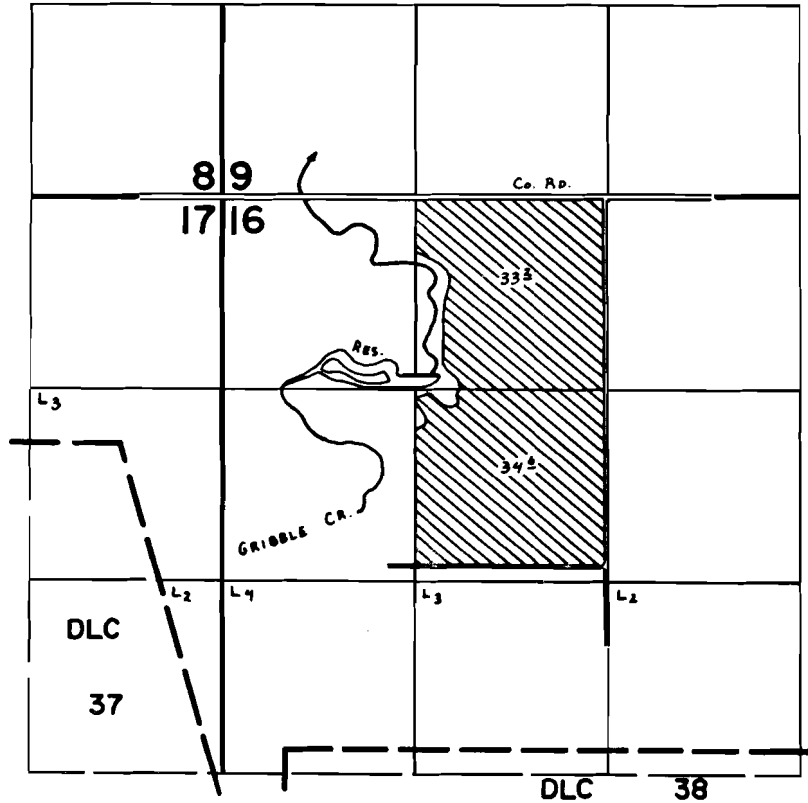

DAM LOC: 1225' S. & 1180' W. fr. N. 1/4 Cor. Sec. 16.

FINAL PROOF SURVEY UNDER

Transfer No. T-3732
 R-56219 R-6598
 Application No. 56220.. Permit No. 41588.....
 IN NAME OF

ERNEST H. PETER

Surveyed Oct. 9, 1979, by C. L. HUGHES....